

MISSISSIPPI DEPARTMENT OF NATURAL RESOURCES

Bureau of Land and Water Resources

Southport Mall

P.O. Box 10631

Jackson, Mississippi 39209

WATER WELL DRILLERS LOG

STONE
D 0031

1-15
date well completed

1987 Frank Price
firm name

Stone
county well located

LANDOWNER:

Mike Parker

description of formations encountered

from to

Top Soil

0 2

(mailing address)

Clay

2 12

WELL LOCATION:

sec. 7 T. 2 N R. 10 E
S W
2 miles N of Wiggins
(distance) (direction) (nearest town)

Hard Sand

12 28

Clay

28 40

Gravel Sand

40 78

WELL PURPOSE:

HOME

(home, irrigation, municipal, industrial)

WELL COMPLETION DATA:

- (1) diameter (inches) 2"
- (2) total depth (feet) 78'
- (3) static water level (feet) 40' below top of ground.
- (4) casing PVC, 73' (material) (depth)

(size) if telescope see back.

- (5) screen 5' length, 73' depth to top
- 2" PVC (size) (material)

- (6) pump 1 HP, 9 (yield gpm)

Elect (type power)

- (7) electric log No (yes or no)

(organization running log)

- (8) how well bottom plugged

BWV

DRILLERS REMARKS:


RECEIVED

OCT 15 1987

Department of Natural Resources
Bureau of Land & Water Resources

If well telescopes please sketch and show depths.

GROUND LEVEL

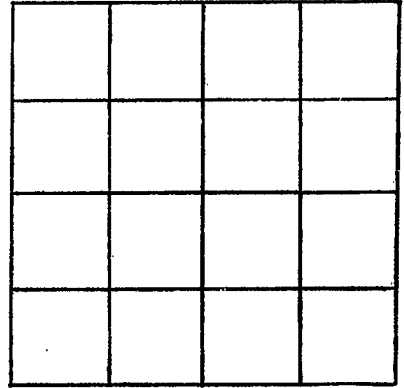

SECTION _____

Please indicate well location X.

ADDITIONAL INFORMATION

If more than one screen, show locations of each on sketch.