

MISSISSIPPI DEPARTMENT OF NATURAL RESOURCES

Bureau of Land and Water Resources

Southport Mall

P.O. Box 10631

Jackson, Mississippi 39209

WATER WELL DRILLERS LOG

STONE  
D 2032

2-11

87 Frank Price

Stone

date well completed

firm name

county well located

LANDOWNER:

Ray Stephens

(mailing address)

description of formations encountered

from

to

Top Soil

0

3

Sandy Clay

3

12

Cruse Sand

12

48

WELL LOCATION:

sec 7 T 2 R 10

W 10

2 1/2

miles

N

of

Whites Crossing

(distance)

(direction)

(nearest town)

WELL PURPOSE:

HOME

(home, irrigation, municipal, industrial)

WELL COMPLETION DATA:

(1) diameter (inches)

2"

(2) total depth (feet)

48'

(3) static water level (feet)

35' below top of ground

(4) casing

PVC

43'

(size)

If telescope see back.

(5) screen

5'

43'

(length)

(depth to top)

(size)

2" PVC

(material)

(6) pump

1

(HP)

8

(yield gpm)

Elect

(type power)

(7) electric log

no

(yes or no)

(organization running log)

(8) how well bottom plugged

BWV

DRILLERS REMARKS:


RECEIVED

OCT 15 1987

Department of Natural Resources  
Bureau of Land & Water Resources

If well telescopes please  
sketch and show depths.

GROUND LEVEL

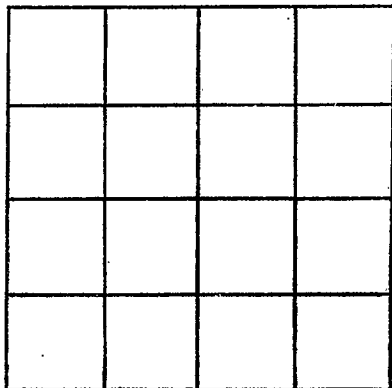

SECTION \_\_\_\_\_

Please indicate well location X.

ADDITIONAL INFORMATION

If more than one screen,  
show locations of each on sketch.