

STONE MISSISSIPPI BOARD OF WATER COMMISSIONERS

EI  
3-10-61

WATER WELL DRILLERS LOG

CODE

Date: Mar 10, 1961, Driller: Joe Miller County Stone  
1538  
2002  
 (Name)

(1) Owner of Land: Rexford Rodgers  
(Name)  
Wiggins Mrs  
(Address) 213233 3.13

(2) Location: 1/4, 1/4, Sec. 29-32-T-2-R-12  
15 miles West, of Perkinston  
(distance) (direction) (Nearest town)

(3) Topography: Hilly  
(Hilly) (Flat) (Level)

(4) Purpose of Well: Park + Sweetwater  
(Domestic Irrigation  
Municipal, Industrial, Other)

Description & Color of Materials Sand, Clay, Red Clay, Shell, etc.	Thick- ness Feet	Depth Feet
Surface	2	2
Red & Wh. Cl.	3	5
Wh. Cl.	19	24
Blu. Cl.	60	84
Blu. Cl.	4	88
Fine Gr. Sand	24	112
Gravel + Wood	3	115
Brown Sand Fine	10	125
Brown Sand Fair	29	154
Gray & Br. (Crane)	24	180

Information upon completion of well:

(1) Diameter 2 inches.

(2) Total Depth 180' feet.

(3) Water Level 41' feet below top of ground.


(4) Cased to 170', Size 2"

(5) Screen: Size 2", Length 10'

(6) Were any formations sealed against pollution?  
 \_\_\_\_\_ yes,  no.

Still in Sand

CODED

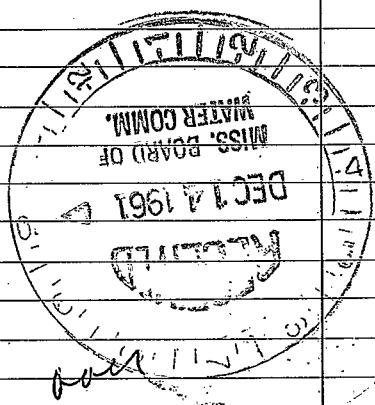

If YES depth of formation \_\_\_\_\_

Why \_\_\_\_\_

Drillers Remarks: \_\_\_\_\_

Running 1800 GPH  
By Air

(Use Back Side)

Well No.

53

McHenry

Well

old 26

Sugar  
Run School