

STONE
E2
5-68

MISSISSIPPI
BOARD OF WATER COMMISSIONERS
416 North State Street
Jackson, Mississippi 39201

CODED

WATER WELL DRILLERS LOG

5-29 1968 Low Smith Stone
date well completed firm name county well located

LANDOWNER: Oa Swilley
Perkinston Miss
R-2
(mailing address)

description of formations encountered

from to

<u>Tap sand</u>	<u>0</u>	<u>2</u>
<u>Clay</u>	<u>2</u>	<u>12</u>
<u>Clay Gravel</u>	<u>12</u>	<u>20</u>
<u>Sand</u>	<u>20</u>	<u>40</u>
<u>Sand & Gravel</u>	<u>40</u>	<u>80</u>

WELL LOCATION:

sec 5 T 3 N R 13 E
S W
12 miles W of Wiggins
(distance) (direction) (nearest town)

WELL PURPOSE:

(home, irrigation, municipal, industrial)

WELL COMPLETION DATA:

- (1) diameter (inches) 2"
(2) total depth (feet) 80
(3) static water level (feet) 68 below above top of ground.
(4) casing Plastic 80 (material) (depth)

_____ if telescope see back.
(size)

- (5) screen 405' 75' (length) (depth to top)
Ø10 Plastic (size) (material)

- (6) pump 1 8 (HP) (yield gpm)
Electric (type power)

- (7) electric log _____ (yes or no)

_____ (organization running log)


- (8) how well bottom plugged Back up

DRILLERS REMARKS:

JUN - 7 1968
MISSISSIPPI BOARD OF
WATER COMMISSIONERS

If well telescopes please sketch and show depths.

GROUND LEVEL

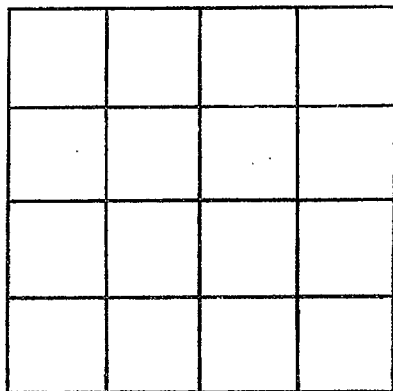

SECTION _____

Please indicate well location X.

ADDITIONAL INFORMATION

If more than one screen, show locations of each on sketch.