

STONE
E3
-68

MISSISSIPPI
BOARD OF WATER COMMISSIONERS
416 North State Street
Jackson, Mississippi 39201

WATER WELL DRILLERS LOG

Parnell Anderson Stone

date well completed 19 firm name county well located

LANDOWNER: <i>Harold Wesson</i>	description of formations encountered	from	to
Perkinston Miss. (mailing address)	Top Soil	0	4
	White Clay	4	42
	Blue Clay	42	174
	Coarse Sand	174	186

WELL LOCATION:
sec. 15 T 3 S R 13 W
8 miles West of Perkinston
(distance) (direction) (nearest town)

WELL PURPOSE:
(home, irrigation, municipal, industrial)

WELL COMPLETION DATA:

- (1) diameter (inches) 2"
- (2) total depth (feet) 186
- (3) static water level (feet) 74' below top of ground.
- (4) casing Plastic 180'
(material) (depth)

 if telescope see back.
(size)

- (5) screen 6' 180
(length) (depth to top)
- 2 Plastic
(size) (material)

- (6) pump 1 6
(HP) (yield gpm)


Electric
(type power)

- (7) electric log No
(yes or no)

(organization running log)


- (8) how well bottom plugged Back Wash Valve

DRILLERS REMARKS:

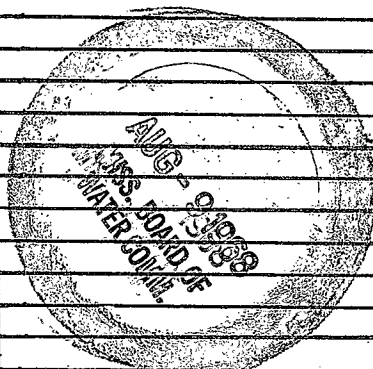

If well telescopes please sketch and show depths.

GROUND LEVEL

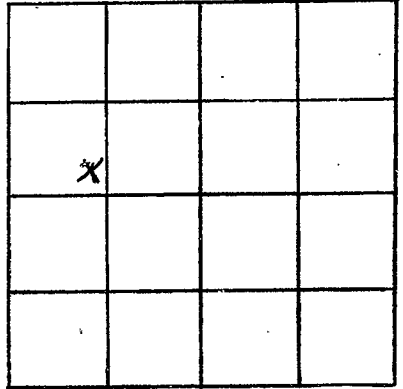

SECTION 15

Please indicate well location X.

ADDITIONAL INFORMATION

If more than one screen, show locations of each on sketch.