

STONE
E5
12-10-68

MISSISSIPPI
 BOARD OF WATER COMMISSIONERS
 416 North State Street
 Jackson, Mississippi 39201

WATER WELL DRILLERS LOG

12-10 1968 Larnell Anderson Stone
 date well completed firm name county well located

LANDOWNER: Frazier Band
Route 2 Foulkinston
Miss
 (mailing address)

description of formations encountered	CODED	
	from	to
Top Soil	0	3
Red Sandy Clay	3	24
Sand	24	32
Red Clay	32	67
Red Fine Sand	67	116
Whit Clay	116	138
Coarse Sand & Gravel	138	150

WELL LOCATION:
 sec 35 T. 3 S * R 13 W
6 miles West of Park
 (distance) (direction) (nearest town)

WELL PURPOSE: Home
 (home, irrigation, municipal, industrial)

WELL COMPLETION DATA:

(1) diameter (inches) 4.0
 (2) total depth (feet) 150
 (3) static water level (feet) 125 below top of ground
 (4) casing Plastic, (depth) _____
 _____ if telescope see back. (size)
 (5) screen 10, 140 (length) (depth to top)
4", Plastic (size) (material)
 (6) pump 3/4, 11 (HP) (yield gpm)
 _____ (type power)
 (7) electric log _____ (yes or no)
 _____ (organization running log)
 (8) how well bottom plugged
Backwash

DRILLERS REMARKS:


CODED

MAR 23 1968

MISSISSIPPI BOARD OF WATER COMMISSIONERS

If well telescopes please sketch and show depths.

GROUND LEVEL

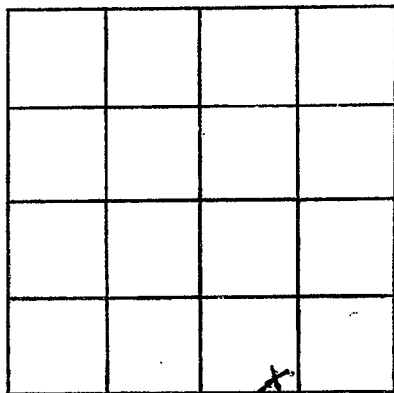

SECTION 35

Please indicate well location X.

ADDITIONAL INFORMATION

If more than one screen, show locations of each on sketch.