

STONE
E 6
2-10-69

MISSISSIPPI
BOARD OF WATER COMMISSIONERS
416 North State Street
Jackson, Mississippi 39201

WATER WELL DRILLERS LOG

INDEXED

Feb 10 1969 Parnell Anderson Stone
date well completed firm name county well located

LANDOWNER: Buddy Clark
Rt 2 Perkinston
(mailing address)

description of formations encountered	from	to
TOP SOIL	0	10
RED CLAY	10	30
FINE SAND	30	45
PINK CLAY	45	3-7
COURSE SAND	5-2	6-3

WELL LOCATION:
sec. 11 T. 3 R. 13
8 miles West of Perkinston
(distance) (direction) (nearest town)

WELL PURPOSE: Home
(home, irrigation, municipal, industrial)

- WELL COMPLETION DATA:
- (1) diameter (inches) 2
 - (2) total depth (feet) 63
 - (3) static water level (feet) 14 below top of ground.
 - (4) casing Plastic, 5-7, (material) (depth)
If telescope see back. (size)
 - (5) screen 6, 5-7 (length) (depth to top)
2, Plastic (size) (material)
 - (6) pump 1, 11 (HP) (yield gpm)
E. lect (type power)
 - (7) electric log no (yes or no)
(organization running log)
 - (8) how well bottom plugged Backwash valve

INDEXED


MAR 20 1969

MISS. Bd. OF WATER COMMISSIONERS

DRILLERS REMARKS:

If well telescopes please sketch and show depths.

GROUND LEVEL

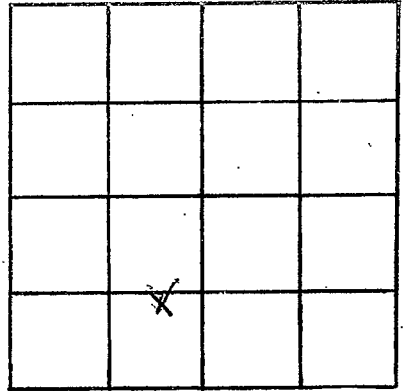

SECTION 11

Please indicate well location X.

ADDITIONAL INFORMATION

If more than one screen, show locations of each on sketch.