

STONE
E7
1-17-70

MISSISSIPPI
BOARD OF WATER COMMISSIONERS
416 North State Street
Jackson, Mississippi 39201

CODED

WATER WELL DRILLERS LOG

1-17-70 date well completed 1970 firm name Hornell Anderson STONE county well located

LANDOWNER: C.G. Odum
Perkinston Miss
(mailing address)

description of formations encountered	from	to
Red Clay	0	18
White Clay	18	24
Blue Clay	24	30
Fine Sand	130	165
Coarse Sand	165	180

WELL LOCATION:
sec. 32 T. 3 S. R. 13
20 miles W of Perkinston
(distance) (direction) (nearest town)

WELL PURPOSE: Home
(home, irrigation, municipal, industrial)

- WELL COMPLETION DATA:
- (1) diameter (inches) 3
 - (2) total depth (feet) 180
 - (3) static water level (feet) 40 below top of ground.
 - (4) casing Plastic, 175 (material) (depth)
(size) If telescope see back.
 - (5) screen 5', 175 (length) (depth to top)
2", Plastic (size) (material)
 - (6) pump 1 (HP) 9 (yield gpm)
Elect (type power)
 - (7) electric log (yes or no)
 - (organization running log)
 - (8) how well bottom plugged


FEB 17 1970

DRILLERS REMARKS:

MISS. Bd. OF WATER COMMISSIONERS

If well telescopes please sketch and show depths.

GROUND LEVEL

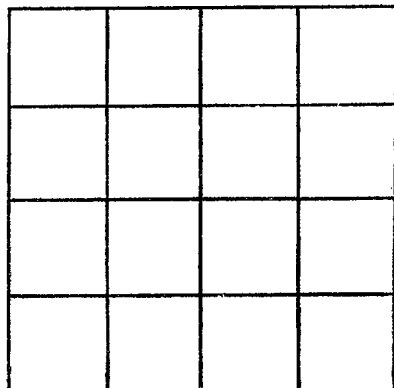

SECTION _____

Please indicate well location X.

ADDITIONAL INFORMATION

If more than one screen, show locations of each on sketch.