

STONE
E 9
8-11-70

MISSISSIPPI
 BOARD OF WATER COMMISSIONERS
 416 North State Street
 Jackson, Mississippi 39201

CODED

WATER WELL DRILLERS LOG

8-11 1970 Parnell Anderson Stone
 date well completed firm name county well located

LANDOWNER M. J. Nugent
Route 3 Perkinston
 (mailing address)

description of fomations encountered	from	to
TOR Soil	0	3
Red Clay	3	27
Fine sand	27	34
White clay	34	47
Blue Clay	47	123
Fine sand	123	138
Blue Clay	138	147
Fine Sand	147	159
Coarse Sand	159	170

WELL LOCATION:
 sec. 33 T. 3 R. 13
 S W
16 miles W of Perkinston
 (distance) (direction) (nearest town)

WELL PURPOSE: Home
 (home, irrigation, municipal, industrial)

- WELL COMPLETION DATA:
- (1) diameter (inches) 2
 - (2) total depth (feet) 170
 - (3) static water level (feet) 48 below top of ground.
 - (4) casing Plastic, 165 (material) (depth)
 - (size) If telescope see back.
 - (5) screen 5, 165 (length) (depth to top)
 - (size) (material) 2, Plastic
 - (6) pump 1, 10 (HP) (yield gpm)
 - (type power) Elect
 - (7) electric log (yes or no)
 - (organization running log)
 - (8) how well bottom plugged Back Wash Valve

CODED


JUN 17 1971

DRILLERS REMARKS:

MISS. BD. OF
 WATER COMMISSIONERS

If well telescopes please sketch and show depths.

GROUND LEVEL

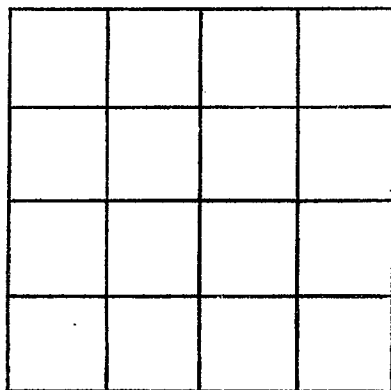

SECTION _____

Please indicate well location X.

ADDITIONAL INFORMATION

If more than one screen, show locations of each on sketch.