

STONE
E-10
6-21-71

MISSISSIPPI
BOARD OF WATER COMMISSIONERS
416 North State Street
Jackson, Mississippi 39201

WATER WELL DRILLERS LOG

CODED

6-21 date well completed 1971 firm name Rarwell Anderson Stone county well located

LANDOWNER: Hoskel Hickman
Route 2 Perkinsian
(mailing address)

description of formations encountered	from	to
TOPSOIL	0	3
Red Sand	3	16
Sand with Gravel	16	21
Red Clay	21	38
Fine Red Sand	38	51
Coarse Sand	51	63

WELL LOCATION:
sec. 33 T. 3 S R. 13 E
W
11 miles W of Perkinsian
(distance) (direction) (nearest town)

WELL PURPOSE: Home
(home, irrigation, municipal, industrial)


- WELL COMPLETION DATA:
- (1) diameter (inches) 2
 - (2) total depth (feet) 63
 - (3) static water level (feet) 40 below above top of ground.
 - (4) casing Plastic (material), (depth)
 - (size) if telescope see back.
 - (5) screen 6 (length), 57 (depth to top)
 - (size), Plastic (material)
 - (6) pump 1 (HP), 10 (yield gpm)
 - Eject (type power)
 - (7) electric log (yes or no)
 - (organization running log)
 - (8) how well bottom plugged Backwash Valve

DRILLERS REMARKS:

AUG 30 1971

If well telescopes please sketch and show depths.

GROUND LEVEL

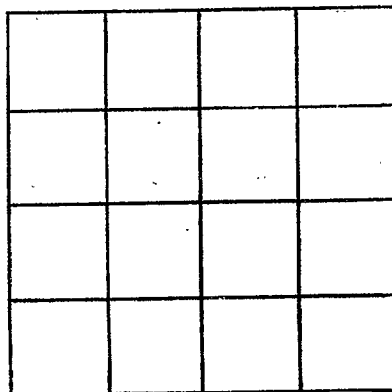

SECTION _____

Please indicate well location X.

ADDITIONAL INFORMATION

If more than one screen, show locations of each on sketch.