

STONE

E 11 CODED

9-17-71

MISSISSIPPI BOARD OF WATER COMMISSIONERS  
416 North State Street  
Jackson, Mississippi 39201

WATER WELL DRILLERS LOG

9-17

1971 Parwell Anderson

Stone

date well completed

firm name

county well located

LANDOWNER: Otha Smith

Rt 3 Lumberton

(mailing address)

description of formations encountered

from

to

TOP Soil

0

2

Red Clay

2

16

Sand Fine

16

28

Coarse Sand & Grav.

28

38

WELL LOCATION:

sec. 4 T 3 S R 15 W  
16 miles W of Perkinston  
(distance) (direction) (nearest town)

WELL PURPOSE: Home  
(home, irrigation, municipal, industrial)

WELL COMPLETION DATA:

- (1) diameter (inches) 2
- (2) total depth (feet) 38
- (3) static water level (feet) 20 below above top of ground.
- (4) casing PVC 33 (material) (depth)

(size) if telescope see back.

- (5) screen 5 33 (length) (depth to top)

2 PVC (size) (material)

- (6) pump 1 10 (HP) (yield gpm)

Elect (type power)

- (7) electric log (yes or no)

(organization running log)

- (8) how well bottom plugged Back Wash Valve


AUG 28 1972

DRILLERS REMARKS:

WATER COMMISSIONERS

If well telescopes please sketch and show depths.

GROUND LEVEL

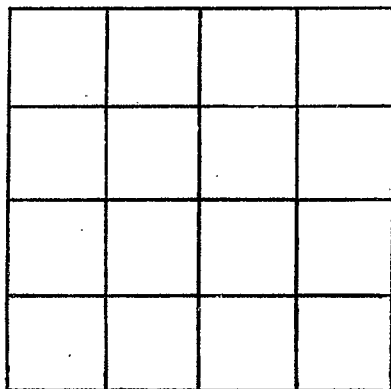

SECTION \_\_\_\_\_

Please indicate well location X.

ADDITIONAL INFORMATION

If more than one screen,  
show locations of each on sketch.