

**MISSISSIPPI  
BOARD OF WATER COMMISSIONERS**  
416 North State Street  
Jackson, Mississippi 39201

**CODED**

**WATER WELL DRILLERS LOG**

**STONE**  
**E 12**  
**1-19-72**

1-19 1972 Parwell Anderson Stone  
date well completed firm name county well located

LANDOWNER: L. W. Rutherford  
Rt 2 Perkinston

description of formations encountered

from to

|             |    |    |
|-------------|----|----|
| TOP Soil    | 0  | 3  |
| Red clay    | 3  | 22 |
| Fine sand   | 22 | 33 |
| Red clay    | 33 | 51 |
| Fine sand   | 51 | 58 |
| Coarse sand | 58 | 70 |

(mailing address)

WELL LOCATION:

sec. 27 T. 3 N. R. 13 E  
S  
10 miles West of Perkinston  
(distance) (direction) (nearest town)

WELL PURPOSE: Home  
(home, irrigation, municipal, industrial)

WELL COMPLETION DATA:

**CODED**


- (1) diameter (inches) 2
- (2) total depth (feet) 70
- (3) static water level (feet) 45 below above top of ground.
- (4) casing Plastic, 65  
(material) (depth)  
         if telescope see back.  
(size)
- (5) screen 5, 65  
(length) (depth to top)  
2, Plastic  
(size) (material)
- (6) pump 1, 10  
(HP) (yield gpm)  
Elec  
(type power)
- (7) electric log           
(yes or no)  
          
(organization running log)
- (8) how well bottom plugged Backwash valve

DRILLERS REMARKS:

DEC 11 1972

If well telescopes please  
sketch and show depths,

GROUND LEVEL

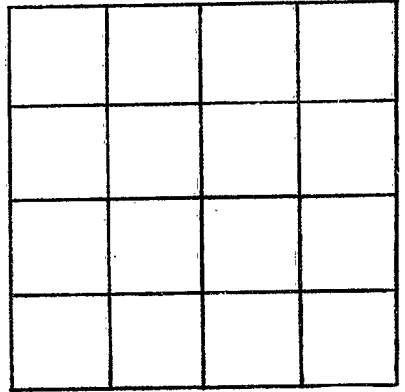

SECTION \_\_\_\_\_

Please indicate well location X.

ADDITIONAL INFORMATION

If more than one screen,  
show locations of each on sketch.