

STONE

E 13

2-9-72

MISSISSIPPI BOARD OF WATER COMMISSIONERS

416 North State Street  
Jackson, Mississippi 39201

CODED

WATER WELL DRILLERS LOG

2-9

1972

Parnell Anderson

Stone

date well completed

firm name

county well located

LANDOWNER: J. B. Brown

Rt 2 Perkinson

(mailing address)

WELL LOCATION:

sec. 18 T 3 S R 13 W

15 miles W of Perkinson  
(distance) (direction) (nearest town)

WELL PURPOSE: HOME  
(home, irrigation, municipal, industrial)

WELL COMPLETION DATA:

- (1) diameter (inches) 2
- (2) total depth (feet) 53
- (3) static water level (feet) 31 below top of ground
- (4) casing Plastic, 48 (material) (depth)

(size) if telescope see back.

- (5) screen 5' 48 (length) (depth to top)
- 2" Plastic (size) (material)

- (6) pump 1 11 (HP) (yield gpm)
- Elect (type power)

- (7) electric log (yes or no)

(organization running log)

- (8) how well bottom plugged Back wash valve

DRILLERS REMARKS:

description of formations encountered

from

to


Top Soil	0	2
Red Sandy clay	2	18
Red Clay	18	26
Fine Sand	26	34
Pink Clay	34	37
Fine sand	37	42
Coarse Sand	42	53

CODED

REG 11 11/72

If well telescopes please sketch and show depths.

GROUND LEVEL

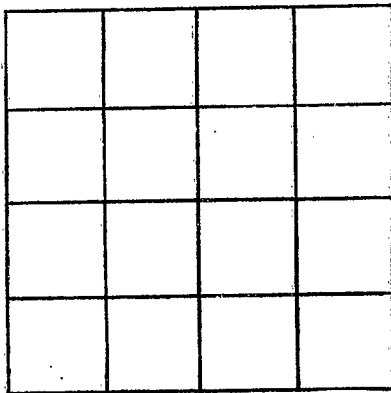

SECTION \_\_\_\_\_

Please indicate well location X.

ADDITIONAL INFORMATION

If more than one screen, show locations of each on sketch.