

STONE  
E 16  
6-1-73

MISSISSIPPI  
BOARD OF WATER COMMISSIONERS  
416 North State Street  
Jackson, Mississippi 39201 **CODED**

WATER WELL DRILLERS LOG

6-1-73 date well completed 1973 firm name Parrell Anderson county well located Stone

LANDOWNER: John H. Smith  
Route 3 Perkinson  
(mailing address)

description of formations encountered	from	to
Top Soil	0	3
Red Sandy Clay	3	21
Sand	21	37
Pink Clay	37	42
Coarse Sand	42	63

WELL LOCATION:  
sec. 5 T 3 N R 13 S W  
1.5 miles West of Wiggins  
(distance) (direction) (nearest town)

WELL PURPOSE: Home  
(home, irrigation, municipal, industrial)

WELL COMPLETION DATA:


- (1) diameter (inches) 2
- (2) total depth (feet) 63
- (3) static water level (feet) 30 below top of ground.
- (4) casing Plastic 58  
(material) (depth)  
\_\_\_\_ if telescope see back.  
(size)
- (5) screen 5, 58  
(length) (depth to top)  
2, Plastic  
(size) (material)
- (6) pump 1 10  
(HP) (yield gpm)  
Elect  
(type power)
- (7) electric log \_\_\_\_\_  
(yes or no)  
\_\_\_\_\_  
(organization running log)
- (8) how well bottom plugged Backwash valve

DRILLERS REMARKS:

NOV 5 1973

If well telescopes please sketch and show depths.

GROUND LEVEL

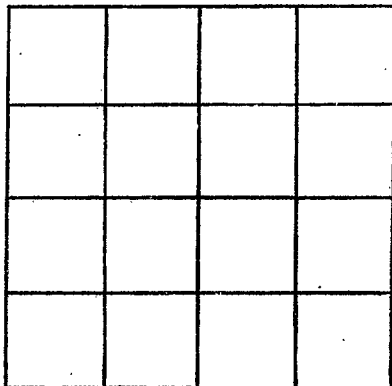

SECTION \_\_\_\_\_

Please indicate well location X.

ADDITIONAL INFORMATION

If more than one screen,  
show locations of each on sketch.