

STONE
E17
5-3-74

MISSISSIPPI
BOARD OF WATER COMMISSIONERS
416 North State Street
Jackson, Mississippi 39201

CODED

WATER WELL DRILLERS LOG

5-3 1974 Parne Anderson Stone
date well completed firm name county well located

LANDOWNER:
Donnie Parker
Rt 2 Park
(mailing address)

description of formations encountered	from	to
<u>Top Soil</u>	<u>0</u>	<u>4</u>
<u>Red Sand</u>	<u>4</u>	<u>16</u>
<u>white clay</u>	<u>16</u>	<u>180</u>
<u>Fine Sand</u>	<u>180</u>	<u>180</u>
<u>Coarse Sand</u>	<u>180</u>	<u>326</u>

WELL LOCATION:
sec. 21 T. 3 R. 13
24 miles W of Park
(distance) (direction) (nearest town)

WELL PURPOSE: HOME
(home, irrigation, municipal, industrial)

WELL COMPLETION DATA:

(1) diameter (inches) 4"

(2) total depth (feet) 326'

(3) static water level (feet) 130' below above top of ground.

(4) casing Plastic 2 1/2" (material) (depth)

 if telescope see back. (size)

(5) screen 10', 2 1/2" (length) (depth to top)

4", Plastic (size) (material)

(6) pump 3/4 (HP) 9 (yield gpm)

Elect (type power)

(7) electric log no (yes or no)

 (organization running log)

(8) how well bottom plugged Back wash valve

CODED


DRILLERS REMARKS:

DECEMBER 1974
JUN - 2 1974

MISS. BO. OF WATER COMMISSIONERS

If well telescopes please sketch and show depths.

GROUND LEVEL

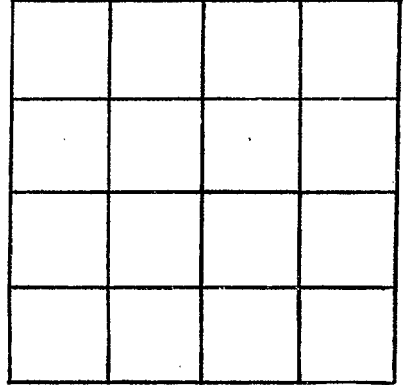

SECTION _____

Please indicate well location X.

ADDITIONAL INFORMATION

If more than one screen, show locations of each on sketch.