

STONE  
E18  
12-11-74

MISSISSIPPI  
BOARD OF WATER COMMISSIONERS  
416 North State Street  
Jackson, Mississippi 39201

CODED

WATER WELL DRILLERS LOG

12-11 1974  
date well completed

Barnell Anderson Stone  
firm name

Stone  
county well located

LANDOWNER:  
Austin Hart  
(mailing address)

description of formations encountered	from	to
Top Soil	0	4
Red Clay	4	12
Fine Sand	12	17
white clay	17	34
Blue clay	34	70
Fine Sand	70	147
Coarse Sand	147	162

WELL LOCATION:  
sec. 32 T 3 S R 13 W  
14 miles W of Park  
(distance) (direction) (nearest town)

WELL PURPOSE: HOME  
(home, irrigation, municipal, industrial)

WELL COMPLETION DATA:

(1) diameter (inches) 2"

(2) total depth (feet) 162'

(3) static water level (feet) 52' below top of ground.

(4) casing Plastic 157' (material) (depth)

(size) If telescope see back.

(5) screen 2" (length) 157' (depth to top)

2" Plastic (size) (material)

(6) pump 1 (HP) 8 (yield gpm)

Elect (type power)

(7) electric log no (yes or no)

(organization running log)

(8) how well bottom plugged back with wire

RECEIVED  
RECEIVED


JAN 3 1975

DRILLERS REMARKS:

MISS. BD. OF WATER COMMISSIONERS

If well telescopes please sketch and show depths.

GROUND LEVEL

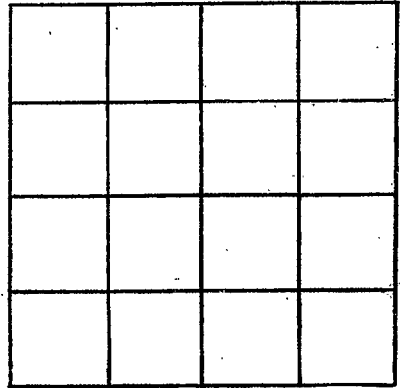

SECTION \_\_\_\_\_

Please indicate well location X.

ADDITIONAL INFORMATION

A series of horizontal lines providing space for additional information.

If more than one screen, show locations of each on sketch.