

STONE  
E 19  
1-31-75

MISSISSIPPI  
BOARD OF WATER COMMISSIONERS  
416 North State Street  
Jackson, Mississippi 39201

WATER WELL DRILLERS LOG CODED

1-31 date well completed      1975 Parnell Anderson firm name      Stone county well located

LANDOWNER:	description of formations encountered	from	to
Wonty A. Batson	Top Soil	0	4
(mailing address)	Sand	4	94
<b>WELL LOCATION:</b>			
sec. <u>11</u> T. <u>3</u> N. R. <u>13</u> E			
S. W. of <u>Park</u>			
<u>8</u> miles (distance) (direction) (nearest town)			
<b>WELL PURPOSE:</b> <u>HOME</u> (home, irrigation, municipal, industrial)			
<b>WELL COMPLETION DATA:</b>			
(1) diameter (inches)	<u>2"</u>		
(2) total depth (feet)	<u>94'</u>		
(3) static water level (feet)	<u>68'</u> below top of ground.		
(4) casing (material)	<u>Plastic</u>		
(depth)	<u>89'</u>		
(size)	If telescope see back.		
(5) screen (length)	<u>3"</u>		
(depth to top)	<u>89'</u>		
(size)	<u>3"</u>		
(material)	<u>Plastic</u>		
(6) pump (HP)	<u>1</u>		
(yield gpm)	<u>9</u>		
(type power)	<u>E lect</u>		
(7) electric log (yes or no)	<u>no</u>		
(organization running log)			
(8) how well bottom plugged	<u>Plugged</u>		
DRILLERS REMARKS:			


CODED

DRILLERS LOG  
FEB 3 - 1975

MISS. BD. OF WATER COMMISSIONERS

If well telescopes please sketch and show depths.

GROUND LEVEL

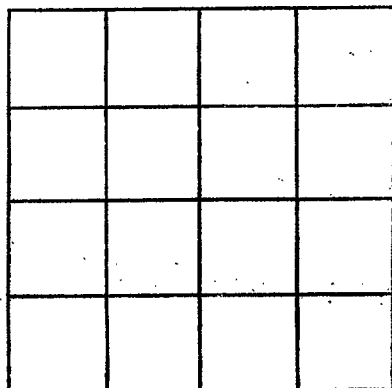

SECTION \_\_\_\_\_

Please indicate well location X.

ADDITIONAL INFORMATION

If more than one screen, show locations of each on sketch.