

Stone
E 20
6-7-75

MISSISSIPPI
BOARD OF WATER COMMISSIONERS
416 North State Street
Jackson, Mississippi 39201

WATER WELL DRILLERS LOG

CODED

6-7 1975
date well completed

Stamm Anderson
firm name

Stone
county well located

LANDOWNER:	description of formations encountered	from	to
John Diamond	Top Soil	0	4
(mailing address)	Sand	4	9.3

WELL LOCATION:
sec. 15 T 3 S R 13 E ¹³⁵
6 miles W of Berkman
(distance) (direction) (nearest town)

CODED

WELL PURPOSE: HOME
(home, irrigation, municipal, industrial)

WELL COMPLETION DATA:

(1) diameter (inches) 2"

(2) total depth (feet) 9.3'

(3) static water level (feet) 39' below above top of ground.

(4) casing Plastic, 88'
(material) (depth)

(size) If telescope see back.

(5) screen 5", 88'
(length) (depth to top)

(size) (material)

(6) pump 1 10
(HP) (yield gpm)

Elect
(type power)

(7) electric log no
(yes or no)

(organization running log)


(8) how well bottom plugged
Berkman Valve

DRILLERS REMARKS:
all sand

RECORDED
INDEXED
JUN - 2 1975

If well telescopes please sketch and show depths.

GROUND LEVEL

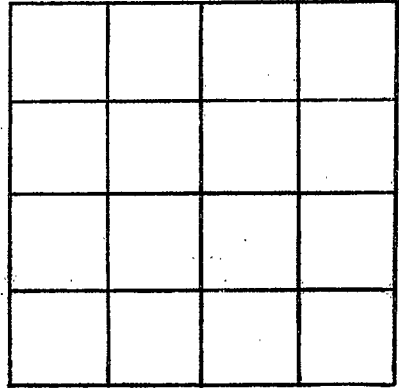

SECTION _____

Please indicate well location X.

ADDITIONAL INFORMATION

If more than one screen, show locations of each on sketch.