

Stone  
E 21  
6-14-75

MISSISSIPPI  
BOARD OF WATER COMMISSIONERS  
416 North State Street  
Jackson, Mississippi 39201


CODED

WATER WELL DRILLERS LOG

6-14-75 date well completed  
1975 Donnell Henderson & Stone firm name  
Stone county well located

LANDOWNER:	description of formations encountered	from	to
A. J. B. Ordley	Top Soil	0	15
(mailing address)	white clay	15	30
WELL LOCATION:	Blue Clay	30	156
sec. 31 T 3 N R 13 E 13 S	Coarse Sand	156	191
14 miles S W of Perk			
(distance) (direction) (nearest town)			
WELL PURPOSE: HOME			
(home, irrigation, municipal, industrial)			
WELL COMPLETION DATA:			
(1) diameter (inches) 3"			
(2) total depth (feet) 191'			
(3) static water level (feet) 58' below top of ground			
(4) casing Plastic 156'			
(material) (depth)			
(size) If telescope see back.			
(5) screen 5' 191'			
(length) (depth to top)			
2" Plastic			
(size) (material)			
(6) pump 1 9			
(HP) (yield gpm)			
Elect			
(type power)			
(7) electric log no			
(yes or no)			
(organization running log)			
(8) how well bottom plugged			
Backwash valve			
DRILLERS REMARKS:			

CODE

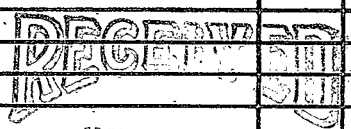


JUL - 2 1975

MISS. BD. OF WATER COMMISSIONERS

If well telescopes please sketch and show depths.

GROUND LEVEL

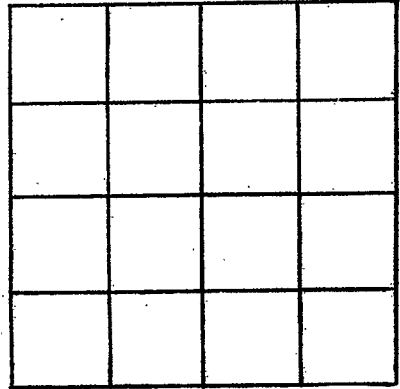

SECTION \_\_\_\_\_

Please indicate well location X.

ADDITIONAL INFORMATION

If more than one screen, show locations of each on sketch.