

Stone
E23
10-5-81

MISSISSIPPI
BOARD OF WATER COMMISSIONERS
416 North State Street
Jackson, Mississippi 39201

CODED

WATER WELL DRILLERS LOG

date well completed 10-5-81 firm name Layne Central Co. county well located Stone

LANDOWNER: Stone Utility Association, Inc
% Batam + Brown
Box 68
Wiggins, Mo. 39577
(mailing address)

description of formations encountered	from	to
Red Clay, Hard	0	12'
Sand + Gravel	12'	40'
White Sand + Pea Gravel	40'	129'
White Clay, Hard	129'	180'
Hard Blue Shale	180'	195'
Sandy Shale	195'	235'
Shale + Sand streaks	235'	281'
Hard Shale	281'	315'
Sandy Shale	315'	375'
Hard Shale	375'	440'
Sand Break	440'	443'
Hard Shale + Sand streaks	443'	484'
Fine Sand	484'	508'
Hard Shale	508'	542'
Coarse Sand + Pea Gravel	542'	641'
Clay Break + Sand streaks	641'	703'
Hard Shale	703'	795'
Sandy Shale	795'	820'
Hard Shale	820'	870'
Sandy Shale	870'	955'
Hard Shale + Sand streaks	955'	980'
Sand + Shale streaks	980'	1042'
Hard Loam	1042'	1046'
Shale + Sand streaks	1046'	1076'
Sand + Shale streaks	1076'	1107'
Coarse Sand + Pea Gravel	1107'	1129'
Coarse Sand	1129'	1162'
Hard Shale	1162'	1210'
Sand + Shale streaks	1210'	1298'
Hard Shale	1298'	1310'

WELL LOCATION:
sec. 4 T 3 N R 13 E
4 miles W of Wiggins
(distance) (direction) (nearest town)

WELL PURPOSE: multi-purpose
(home, irrigation, municipal, industrial)

WELL COMPLETION DATA:

(1) diameter (inches) 10"

(2) total depth (feet) 1131

(3) static water level (feet) 244 below top of ground.

(4) casing St. Steel, 1080,
(material) (depth)
10" If telescope see back.
(size)

(5) screen 40', 60'
(length) (depth to top)
6", Stainless Steel
(size) (material)

(6) pump 40, 250
(HP) (yield gpm)
Electric
(type power)

(7) electric log YES
(yes or no)
Ms. Bonaw of Geology
(organization running log)

(8) how well bottom plugged Back
Pressure Valve

DEPT. OF NATURAL RESOURCES
BUREAU OF LAND & WATER RESOURCES



FEB - 8 1982

RECEIVED

DRILLERS REMARKS:

(X)

If well telescopes please sketch and show depths.

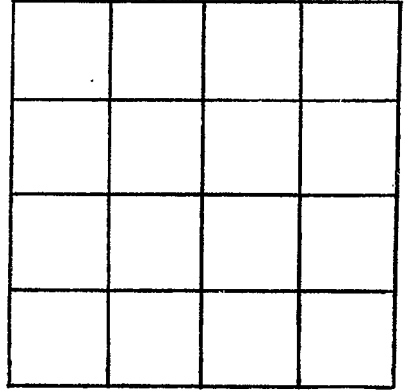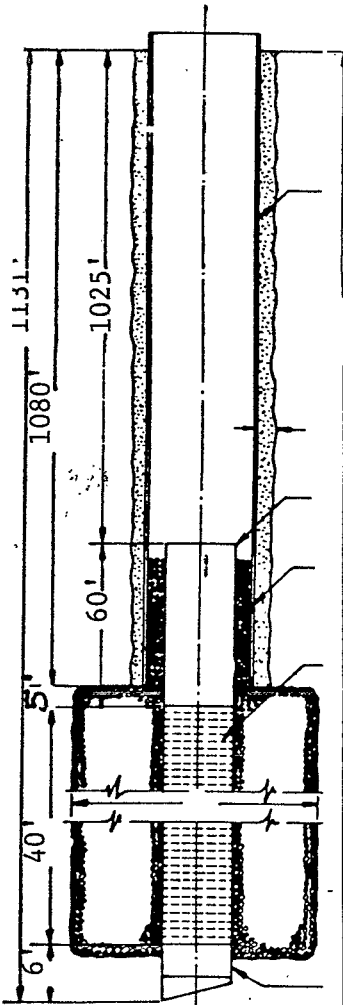

SECTION _____

Please indicate well location X.

ADDITIONAL INFORMATION

If more than one screen, show locations of each on sketch.