


Stone
E 2001
1-2-76

MISSISSIPPI
BOARD OF WATER COMMISSIONERS
416 North State Street
Jackson, Mississippi 39201

WATER WELL DRILLERS LOG

1-2 1976 Samell Anderson Stone
date well completed firm name county well located

LANDOWNER:	description of formations encountered	from	to
Levi Harold	Top Soil	0	4
(mailing address)	White Clay	4	28
WELL LOCATION:	Fine Sand	28	96'
sec. 31 T 3 N R 13 E	Blue Clay	96	130
12 miles W of Wiggins	Coarse Sand	130	142
(distance) (direction) (nearest town)			
WELL PURPOSE: HOME			
(home, irrigation, municipal, industrial)			
WELL COMPLETION DATA:			
(1) diameter (inches) 2"			
(2) total depth (feet) 142'			
(3) static water level (feet) 32' below top of ground			
(4) casing Plastic 137' (material) (depth)			
(size) If telescope see back.			
(5) screen 5' 137' (length) (depth to top)			
2" Plastic (size) (material)			
(6) pump 1 12 (HP) (yield gpm)			
Elect (type power)			
(7) electric log No (yes or no)			
(organization running log)			
(8) has well bottom plugged Backwash valve			
DRILLERS REMARKS:			

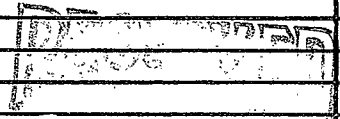


FEB 4 - 1976

MISS. BD. OF WATER COMM

If well telescopes please
sketch and show depths.

GROUND LEVEL

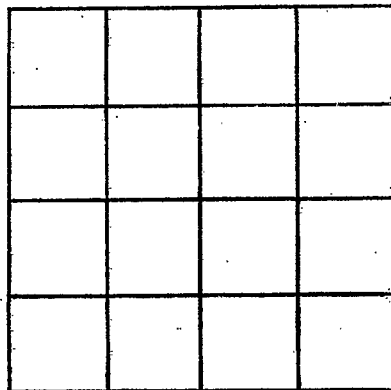

SECTION _____

Please indicate well location X.

ADDITIONAL INFORMATION

If more than one screen,
show locations of each on sketch.