

Stone  
E 2002  
1-6-76

MISSISSIPPI  
BOARD OF WATER COMMISSIONERS  
416 North State Street  
Jackson, Mississippi 39201

WATER WELL DRILLERS LOG

1-6 1976 Parrell Anderson Stone  
date well completed firm name county well located

LANDOWNER:	description of formations encountered	from	to
<u>Tory Smith</u>	<u>Top Soil</u>	<u>0</u>	<u>2</u>
(mailing address)	<u>Red Clay</u>	<u>4</u>	<u>38</u>
WELL LOCATION:	<u>Coarse Sand</u>	<u>54</u>	<u>85</u>
sec. <u>8</u> T. <u>3</u> R. <u>13</u> S W W			
<u>12</u> miles <u>SW</u> of <u>Wiggins</u>			
(distance) (direction) (nearest town)			
WELL PURPOSE: <u>HOME</u>			
(home, irrigation, municipal, industrial)			
WELL COMPLETION DATA:			
(1) diameter (inches) <u>3"</u>			
(2) total depth (feet) <u>85'</u>			
(3) static water level (feet) <u>57'</u> below top of ground.			
(4) casing <u>Plastic</u> <u>80'</u>			
(material) (depth)			
(size) If telescope see back.			
(5) screen <u>5'</u> <u>80'</u>			
(length) (depth to top)			
<u>2"</u> <u>Plastic</u>			
(size) (material)			
(6) pump <u>1</u> <u>8</u>			
(HP) (yield gpm)			
<u>Elect</u>			
(type power)			
(7) electric log <u>No</u>			
(yes or no)			
(organization running log)			
(8) how well bottom plugged <u>Barbed wire</u>			
DRILLERS REMARKS:			


REGISTERED

FEB 4 1976

MISS. BD. OF WATER COMM

If well telescopes please sketch and show depths.

GROUND LEVEL

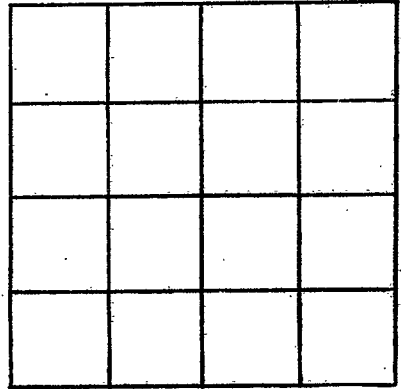

SECTION \_\_\_\_\_

Please indicate well location X.

ADDITIONAL INFORMATION

If more than one screen, show locations of each on sketch.