

Need address

STONE
E 2004
5-19-76

MISSISSIPPI
BOARD OF WATER COMMISSIONERS
416 North State Street
Jackson, Mississippi 39201

WATER WELL DRILLERS LOG

5-19-76
date well completed

132
Danne Anderson Stone
firm name

county well located

LANDOWNER:	description of formations encountered	from	to
Houston Jones (mailing address)			
WELL LOCATION:	Red Clay	3	18
sec 10 T 3 S R 13 E 9 miles W of Park (distance) (direction) (nearest town)	Coarse Sand	18	65
WELL PURPOSE: HOME (home, irrigation, municipal, industrial)			
WELL COMPLETION DATA:			
(1) diameter (inches) 2"			
(2) total depth (feet) 65'			
(3) static water level (feet) 34' below top of ground			
(4) casing Plastic 60' (material) (depth)			
(size) if telescope see back.			
(5) screen 5' 60' (length) (depth to top)			
2" Plastic (size) (material)			
(6) pump 1 (HP) 3 (yield gpm)			
Elect (type power)			
(7) electric log No (yes or no)			
(organization running log)			
(8) how well bottom plugged Capped			
DRILLERS REMARKS:			


RECEIVED
MAY 19 1976

MAY 19 1976

MISS. Bd. of WATER COMMISSIONERS

If well telescopes please sketch and show depths.

GROUND LEVEL

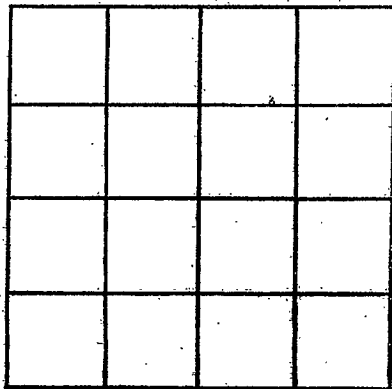

SECTION _____

Please indicate well location X.

ADDITIONAL INFORMATION

If more than one screen, show locations of each on sketch.