


Stone
E 2007
12/27/76

MISSISSIPPI
BOARD OF WATER COMMISSIONERS
416 North State Street
Jackson, Mississippi 39201

WATER WELL DRILLERS LOG

12-27-76 Parnell Anderson Stone
date well completed firm name county well located

LANDOWNER:	description of formations encountered	from	to
Clinton Brown	Top Soil	0	3
(mailing address)	Red Clay	3	28
WELL LOCATION:	Fine Sand	28	33
sec. <u>5</u> T. <u>3</u> S. R. <u>13</u> W.	Coarse Sand	33	56
<u>12</u> miles <u>W</u> of <u>Wiggins</u>			
(distance) (direction) (nearest town)			
WELL PURPOSE: <u>HOME</u>			
(home, irrigation, municipal, industrial)			
WELL COMPLETION DATA:			
(1) diameter (inches) <u>2"</u>			
(2) total depth (feet) <u>56'</u>			
(3) static water level (feet) <u>33'</u> below top of ground			
(4) casing <u>Plaster</u> (<u>51'</u>) (material) (depth)			
(size) If telescope see back.			
(5) screen <u>5'</u> (<u>51'</u>) (length) (depth to top)			
<u>2"</u> (<u>Plastic</u>) (size) (material)			
(6) pump <u>3/4</u> (<u>7</u>) (HP) (yield gpm)			
<u>Elect</u> (type power)			
(7) electric log <u>no</u> (yes or no)			
(organization running log)			
(8) how well bottom plugged <u>Capped</u>			
DRILLERS REMARKS:			

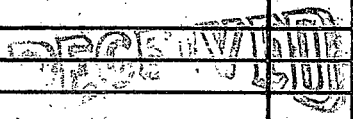


JAN 5 1977

MISSISSIPPI BOARD OF WATER COMMISSIONERS

If well telescopes please sketch and show depths.

GROUND LEVEL

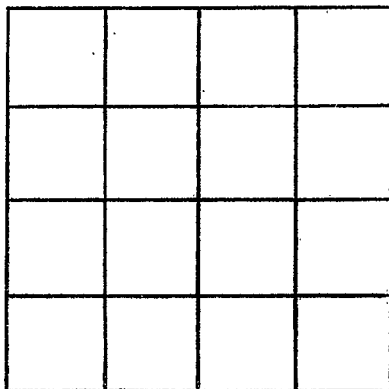

SECTION _____

Please indicate well location X.

ADDITIONAL INFORMATION

If more than one screen,
show locations of each on sketch.