

STONE  
 E 2008  
 2/8/77

MISSISSIPPI  
 BOARD OF WATER COMMISSIONERS  
 416 North State Street  
 Jackson, Mississippi 39201

WATER WELL DRILLERS LOG

2-8 1977 Donnell Anderson Stone  
 date well completed firm name county well located


LANDOWNER:	description of formations encountered	from	to
<u>P. G. Wickman</u>	<u>Topsoil</u>	<u>0</u>	<u>2</u>
(mailing address)	<u>white clay</u>	<u>2</u>	<u>18</u>
WELL LOCATION:	<u>B. blue clay</u>	<u>18</u>	<u>88</u>
sec. <u>31</u> T. <u>3</u> N. R. <u>11E</u>	<u>fine sand</u>	<u>88</u>	<u>155</u>
<u>12</u> miles <u>W</u> of <u>Perk</u>	<u>course sand</u>	<u>155</u>	<u>170</u>
(distance) (direction) (nearest town)			
WELL PURPOSE: <u>HOME</u> (home, irrigation, municipal, industrial)			
WELL COMPLETION DATA:			
(1) diameter (inches) <u>2"</u>			
(2) total depth (feet) <u>170'</u>			
(3) static water level (feet) <u>38'</u> below above top of ground.			
(4) casing <u>Plastic</u> , <u>165'</u> (material) (depth)			
(size) if telescope see back.			
(5) screen <u>3"</u> , <u>165'</u> (length) (depth to top)			
<u>2"</u> , <u>Plastic</u> (size) (material)			
(6) pump <u>1</u> , <u>10</u> (HP) (yield gpm)			
<u>Elect</u> (type power)			
(7) electric log <u>no</u> (yes or no)			
(organization running log)			
(8) how well bottom plugged <u>Backfilled</u>			
DRILLERS REMARKS:			

RECEIVED  
 MAR - 9 1977

MISS. BD. OF WATER COMMISSIONERS

If well telescopes please sketch and show depths.

GROUND LEVEL

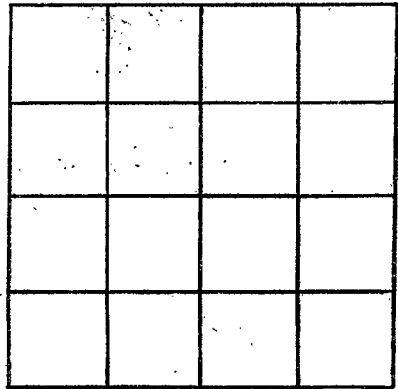

SECTION \_\_\_\_\_

Please indicate well location X.

ADDITIONAL INFORMATION

If more than one screen, show locations of each on sketch.