

Stone
E 2007
2-11-77

MISSISSIPPI
BOARD OF WATER COMMISSIONERS
416 North State Street
Jackson, Mississippi 39201

WATER WELL DRILLERS LOG

2-11 1977 Parrell Anderson Stone
date well completed firm name county well located


LANDOWNER:	description of formations encountered	from	to
<u>John Barnes</u> (mailing address)	<u>Top Soil</u>	0	2
	<u>White Clay</u>	2	15
WELL LOCATION: sec. <u>31</u> T. <u>3</u> S. R. <u>13</u> E. <u>12</u> miles <u>W</u> of <u>Perk</u> (distance) (direction) (nearest town)	<u>Blue Clay</u>	15	97
WELL PURPOSE: <u>HOME</u> (home, irrigation, municipal, industrial)	<u>Course Sand</u>	97	132
WELL COMPLETION DATA:			
(1) diameter (inches) <u>2"</u>			
(2) total depth (feet) <u>132</u>			
(3) static water level (feet) <u>57</u> below top of ground.			
(4) casing <u>Plastic 127'</u> (material) (depth)			
(size) If telescope see back.			
(5) screen <u>5'</u> , <u>127'</u> (length) (depth to top)			
<u>2"</u> , <u>Plastic</u> (size) (material)			
(6) pump <u>1</u> <u>9</u> (HP) (yield gpm)			
<u>Elect</u> (type power)			
(7) electric log <u>no</u> (yes or no)			
(organization running log)			
(8) how well bottom plugged <u>Capped</u>			
DRILLERS REMARKS:			

RECEIVED
MAR - 9 1977

MISS. BD. OF WATER

If well telescopes please sketch and show depths.

GROUND LEVEL

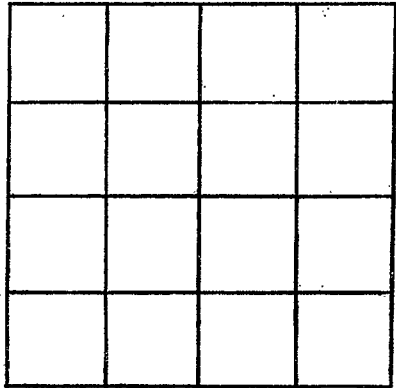

SECTION _____

Please indicate well location X.

ADDITIONAL INFORMATION

If more than one screen,
show locations of each on sketch.