

Stone
E 2010
2-17-77

MISSISSIPPI
BOARD OF WATER COMMISSIONERS
416 North State Street
Jackson, Mississippi 39201

WATER WELL DRILLERS LOG

2-17 1977 Parnell Anderson Stone
date well completed firm name county well located


LANDOWNER:	description of formations encountered	from	to
<u>Lavon Moore</u>	<u>Top Soil</u>	<u>0</u>	<u>3</u>
(mailing address)	<u>Red Sandy Clay</u>	<u>3</u>	<u>28</u>
WELL LOCATION:	<u>Fine Sand</u>	<u>28</u>	<u>52</u>
sec. <u>8</u> T. <u>3</u> S. R. <u>13</u> W.	<u>Clay</u>	<u>52</u>	<u>58</u>
<u>12</u> miles <u>SW</u> of <u>Wiggins</u>	<u>Coarse Sand</u>	<u>58</u>	<u>76</u>
WELL PURPOSE: <u>Municipal</u> (home, irrigation, municipal, industrial)			
WELL COMPLETION DATA:			
(1) diameter (inches) <u>2"</u>			
(2) total depth (feet) <u>76'</u>			
(3) static water level (feet) <u>59'</u> below top of ground.			
(4) casing <u>Plastic</u> , <u>71'</u> (material) (depth)			
(size) If telescope see back.			
(5) screen <u>5'</u> , <u>71'</u> (length) (depth to top)			
<u>2"</u> , <u>Plastic</u> (size) (material)			
(6) pump <u>1</u> , <u>8</u> (HP) (yield gpm)			
<u>Elect</u> (type power)			
(7) electric log <u>no</u> (yes or no)			
(organization running log)			
(8) how well bottom plugged <u>Capped</u>			
DRILLERS REMARKS:			

RECEIVED
MARCH - 9 1977

MISS. BD. OF WATER COMMISSIONERS

If well telescopes please sketch and show depths.

GROUND LEVEL

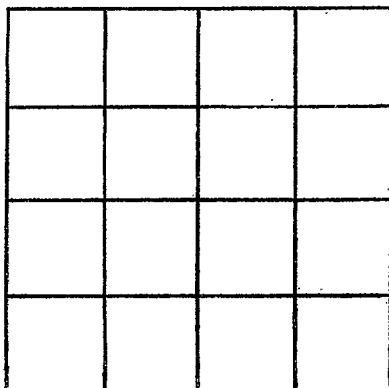

SECTION _____

Please indicate well location X.

ADDITIONAL INFORMATION

If more than one screen, show locations of each on sketch.