

Stone  
E 200  
3-21-77

MISSISSIPPI  
BOARD OF WATER COMMISSIONERS  
416 North State Street  
132 Jackson, Mississippi 39201

WATER WELL DRILLERS LOG

3-21-77 date well completed 1977 firm name *Samuel Anderson* Stone county well located


LANDOWNER:	description of formations encountered	from	to
<i>Lorden Davis</i>	<i>Top Soil</i>	<i>0</i>	<i>3</i>
(mailing address)	<i>Red Clay</i>	<i>3</i>	<i>15</i>
WELL LOCATION:	<i>Course Sand</i>	<i>15</i>	<i>24</i>
sec. <i>11</i> T. <i>3</i> N. R. <i>13</i> E. S. <i>8</i>	<i>Pink Clay</i>	<i>24</i>	<i>33</i>
<i>8</i> miles <i>W</i> of <i>Berk</i>	<i>Course Sand</i>	<i>33</i>	<i>65</i>
(distance) (direction) of (nearest town)			
WELL PURPOSE: <i>HOME</i> (home, irrigation, municipal, industrial)			
WELL COMPLETION DATA:			
(1) diameter (inches) <i>2"</i>			
(2) total depth (feet) <i>65'</i>			
(3) static water level (feet) <i>41</i> below above top of ground.			
(4) casing <i>Plastic, 60'</i> (material) (depth)			
(size) If telescope see back.			
(5) screen <i>5'</i> , <i>60'</i> (length) (depth to top)			
<i>2"</i> , <i>Plastic</i> (size) (material)			
(6) pump <i>1</i> , <i>9</i> (HP) (yield gpm)			
<i>Elect</i> (type power)			
(7) electric log <i>no</i> (yes or no)			
(organization running log)			
(8) how well bottom plugged <i>Capped</i>			
DRILLERS REMARKS:			

**RECEIVED**  
APR 7 1977

MISS. BD. OF WATER COMM.

If well telescopes please sketch and show depths.

GROUND LEVEL

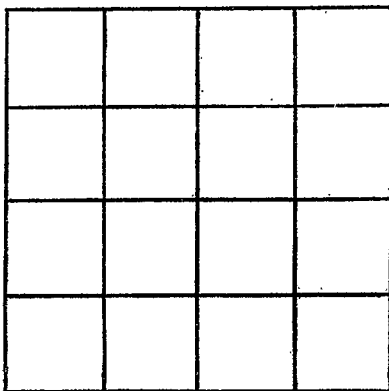

SECTION \_\_\_\_\_

Please indicate well location X.

ADDITIONAL INFORMATION

If more than one screen,  
show locations of each on sketch.