

STONE
E 2012
6-23-77

MISSISSIPPI
BOARD OF WATER COMMISSIONERS
416 North State Street
135 Jackson, Mississippi 39201

WATER WELL DRILLERS LOG

6-23-77 date well completed
1977 *Samuel Anderson Stone* firm name
Stone county well located

LANDOWNER:	description of formations encountered	from	to
<i>Clarence Galle</i>	<i>Top Soil</i>	<i>0</i>	<i>2</i>
(mailing address)	<i>white clay</i>	<i>2</i>	<i>78</i>
WELL LOCATION:	<i>fine sand</i>	<i>78</i>	<i>85</i>
sec. <i>32</i> T. <i>3</i> S. R. <i>13</i> W.	<i>Clay</i>	<i>85</i>	<i>147</i>
<i>12</i> miles <i>SW</i> of <i>Perk</i>	<i>Coarse Sand</i>	<i>147</i>	<i>165</i>
(distance) (direction) (nearest town)			

WELL PURPOSE: *HOME*
(home, irrigation, municipal, industrial)


- WELL COMPLETION DATA:
- (1) diameter (inches) *2"*
 - (2) total depth (feet) *165*
 - (3) static water level (feet) *64* below top of ground.
 - (4) casing *Plastic 160'*
(material) (depth)
 - (size) if telescope see back.
 - (5) screen *3" 160'*
(length) (depth to top)
 - 2" Plastic*
(size) (material)
 - (6) pump *1 9*
(HP) (yield gpm)
 - Elect*
(type power)
 - (7) electric log *no*
(yes or no)
 - (organization running log)
 - (8) how well bottom plugged *Clipped*

DRILLERS REMARKS:

RECEIVED
MAY 5 - 1977

If well telescopes please sketch and show depths.

GROUND LEVEL

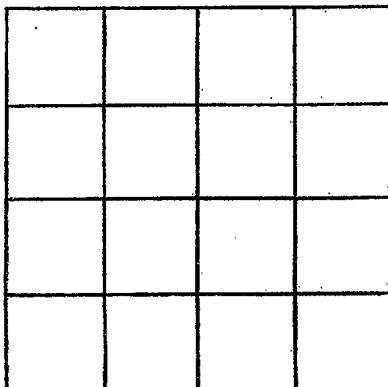

SECTION _____

Please indicate well location X.

ADDITIONAL INFORMATION

If more than one screen, show locations of each on sketch.