

STONE
E 2013
6-24-77

MISSISSIPPI
 BOARD OF WATER COMMISSIONERS
 416 North State Street
 130 Jackson, Mississippi 39201

WATER WELL DRILLERS LOG

6-24-77 date well completed 1977 firm name *Samuel Anderson* Stone county well located

LANDOWNER:	description of formations encountered	from	to
<i>W. H. Spikes</i>	<i>Top Soil</i>	<i>0</i>	<i>2</i>
(mailing address)	<i>Course Sand</i>	<i>2</i>	<i>105</i>

WELL LOCATION:
 sec. *12* T. *3* S. R. *13* E.
7 miles *E* of *Park*
 (distance) (direction) (nearest town)

WELL PURPOSE: *HOME*
 (home, irrigation, municipal, industrial)


- WELL COMPLETION DATA:
- (1) diameter (inches) *2"*
 - (2) total depth (feet) *105'*
 - (3) static water level (feet) *60'* below top of ground.
 - (4) casing *Plastic, 100'*
 (material) (depth)
 (size) if telescope see back.
 - (5) screen *5" 100'*
 (length) (depth to top)
5" Plastic
 (size) (material)
 - (6) pump *1* *10*
 (HP) (yield gpm)
Electric
 (type power)
 - (7) electric log *no*
 (yes or no)
 - (organization running log)
 - (8) how well bottom plugged *cap*

DRILLERS REMARKS:

RECEIVED
 JUL 5 1977

If well telescopes please sketch and show depths.

GROUND LEVEL

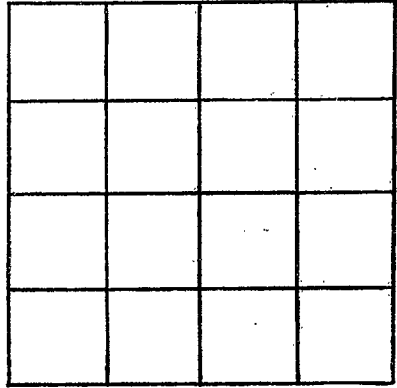

SECTION _____

Please indicate well location X.

ADDITIONAL INFORMATION

If more than one screen, show locations of each on sketch.