

Stone  
E 2015  
3/2/78

MISSISSIPPI  
BOARD OF WATER COMMISSIONERS  
416 North State Street  
Jackson, Mississippi 39201

WATER WELL DRILLERS LOG

3-2 1978 Garnell Andersen Stone  
date well completed firm name county well located

LANDOWNER:  
Orcas Swilley  
(mailing address)

description of formations encountered	from	to
<u>Top Soil</u>	<u>0</u>	<u>2</u>
<u>Red Clay</u>	<u>2</u>	<u>16</u>
<u>Fine Sand</u>	<u>16</u>	<u>72</u>
<u>Coarse Sand</u>	<u>72</u>	<u>85</u>

WELL LOCATION:  
sec. 5 T. 3 S. R. 13 W.  
12 miles SW of Wiggins  
(distance) (direction) (nearest town)

WELL PURPOSE: HOME  
(home, irrigation, municipal, industrial)

- WELL COMPLETION DATA:
- (1) diameter (inches) 2"
  - (2) total depth (feet) 83'
  - (3) static water level (feet) 34' below top of ground.
  - (4) casing Plastic, 80'  
(material) (depth)
  - (size) if telescope see back.
  - (5) screen 5", 80'  
(length) (depth to top)
  - 2", Plastic  
(size) (material)
  - (6) pump 1, 10  
(HP) (yield gpm)
  - Elect  
(type power)
  - (7) electric log no  
(yes or no)
  - (organization running log)
  - (8) how well bottom plugged Capped


RECEIVED  
APR - 7 1978

DRILLERS REMARKS:

MISS. BD. OF WATER COMMISSIONERS

If well telescopes please sketch and show depths.

GROUND LEVEL

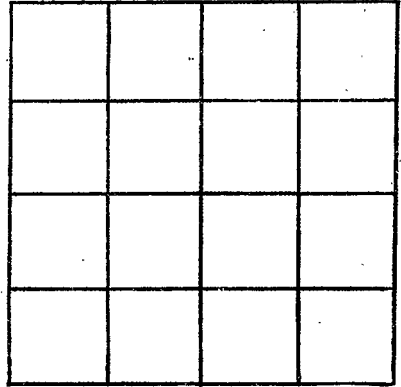

SECTION \_\_\_\_\_

Please indicate well location X.

ADDITIONAL INFORMATION

If more than one screen, show locations of each on sketch.