

STONE
 E 206
 4-21-78

MISSISSIPPI
 BOARD OF WATER COMMISSIONERS
 416 North State Street
 Jackson, Mississippi 39201

WATER WELL DRILLERS LOG

4-21-1978 *Stone* *D Stone*
 date well completed firm name county well located

LANDOWNER:
Horace Hickman
 Horace
 (mailing address)

description of formations encountered	from	to
<i>Top Soil</i>	<i>0</i>	<i>2</i>
<i>Blue Clay</i>	<i>2</i>	<i>74</i>
<i>Course of Sand</i>	<i>74</i>	<i>85</i>

WELL LOCATION:
 sec *25* T *43* N R *13* E
10 miles *NW* of *McHenry*
 (distance) (direction) (nearest town)

WELL PURPOSE: *HOME*
 (home, irrigation, municipal, industrial)

WELL COMPLETION DATA:

(1) diameter (inches) *2"*

(2) total depth (feet) *85'*

(3) static water level (feet) *48* below top of ground.

(4) casing *Plastic* *80'*
 (material) (depth)

(size) if telescope see back.

(5) screen *5'* *80'*
 (length) (depth to top)

2" *Plastic*
 (size) (material)

(6) pump *1* *10*
 (HP) (yield gpm)

Elect
 (type power)

(7) electric log *no*
 (yes or no)

(organization running log)

(8) how well bottom plugged *capped*


DRILLERS REMARKS:

RECEIVED
 MAY 8 1978

MISS. BD. OF WATER COMMISSIONERS

If well telescopes please sketch and show depths.

GROUND LEVEL

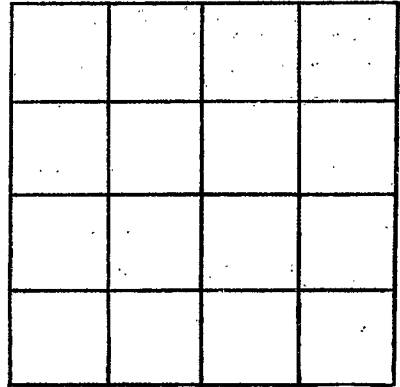

SECTION _____

Please indicate well location X.

ADDITIONAL INFORMATION

If more than one screen, show locations of each on sketch.