

STONE  
 E 2020  
 11-13-78

MISSISSIPPI  
 BOARD OF WATER COMMISSIONERS  
 416 North State Street  
 Jackson, Mississippi 39201

WATER WELL DRILLERS LOG

11-13 1978 Pernell Anderson Stone  
 date well completed firm name county well located

LANDOWNER:  
Bill Hatten  
 (mailing address)

| description of formations encountered | from      | to        |
|---------------------------------------|-----------|-----------|
| <u>Top Soil</u>                       | <u>0</u>  | <u>3</u>  |
| <u>Red clay</u>                       | <u>3</u>  | <u>20</u> |
| <u>Coarse Sand</u>                    | <u>20</u> | <u>53</u> |

WELL LOCATION:  
 sec 11 T 3 N R 13 E  
10 miles W of Perk  
 (distance) (direction) (nearest town)

WELL PURPOSE: HOME  
 (home, irrigation, municipal, industrial)

WELL COMPLETION DATA:

(1) diameter (inches) 2"

(2) total depth (feet) 53'

(3) static water level (feet) 45' below top of ground.

(4) casing Plastic, 48'  
 (material) (depth)

\_\_\_\_\_ If telescope see back.  
 (size)

(5) screen 5', 48'  
 (length) (depth to top)

2", Plastic  
 (size) (material)

(6) pump 1, 9  
 (HP) (yield gpm)

Elect  
 (type power)

(7) electric log no  
 (yes or no)

\_\_\_\_\_ (organization running log)

(8) how well bottom plugged  
Capped


DRILLERS REMARKS:

RECEIVED  
 DEC - 7 1978

MISS. BD. OF WATER COMM.

If well telescopes please sketch and show depths.

GROUND LEVEL

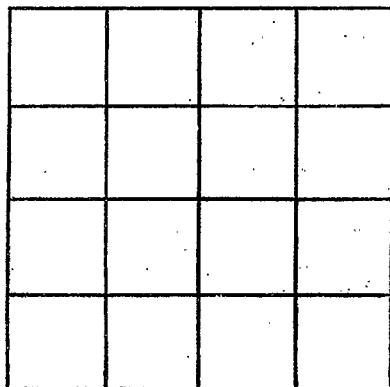

SECTION \_\_\_\_\_

Please indicate well location X.

ADDITIONAL INFORMATION

If more than one screen,  
show locations of each on sketch.