

STONE
E 2023
2-15-79

MISSISSIPPI
BOARD OF WATER COMMISSIONERS
416 North State Street
Jackson, Mississippi 39201

WATER WELL DRILLERS LOG

2-15-79 date well completed
1979 Pernell Anderson firm name
Stone county well located

LANDOWNER:
J. B. Brown
(mailing address)

description of formations encountered	from	to
<u>Top Soil</u>	<u>0</u>	<u>2</u>
<u>Red Clay</u>	<u>2</u>	<u>14</u>
<u>Course Sand</u>	<u>14</u>	<u>50</u>

WELL LOCATION:
sec. 7 T 8 N R 13 E
S
12 miles W of Perk
(distance) (direction) (nearest town)

WELL PURPOSE: HOME
(home, irrigation, municipal, industrial)

WELL COMPLETION DATA:

(1) diameter (inches) 2"

(2) total depth (feet) 50'

(3) static water level (feet) 37' below above top of ground.

(4) casing Plastic 45'
(material) (depth)

_____ if telescope see back.
(size)

(5) screen 5" 45'
(length) (depth to top)

2" Plastic
(size) (material)

(6) pump 1/2 12
(HP) (yield'gpm)

Elect
(type power)

(7) electric log no
(yes or no)

_____ (organization running log)

(8) how well bottom plugged Capped

Miss. Board of Water Comm.


MAR 5 1979

RECEIVED

DRILLERS REMARKS:

If well telescopes please sketch and show depths.

GROUND LEVEL

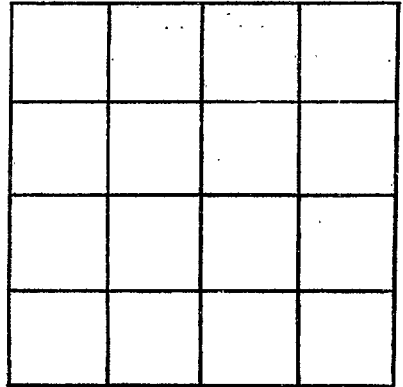

SECTION _____

Please indicate well location X.

ADDITIONAL INFORMATION

If more than one screen,
show locations of each on sketch.