

Stone
E 2024
12-5-79

MISSISSIPPI
 BOARD OF WATER COMMISSIONERS
 416 North State Street
 Jackson, Mississippi 39201

WATER WELL DRILLERS LOG

12-5- 1979 Parrell Anderson Stone
 date well completed firm name county well located

LANDOWNER:	description of formations encountered	from	to
<u>Grady Diamond</u>	<u>Top Soil</u>	<u>0</u>	<u>3</u>
(mailing address)	<u>Fin Sand</u>	<u>3</u>	<u>88</u>
WELL LOCATION:	<u>Coarse Sand</u>	<u>88</u>	<u>105</u>
sec. <u>13</u> T <u>3</u> N R <u>13</u> E			
<u>7</u> miles <u>W</u> of <u>Perk</u>			
(distance) (direction) (nearest town)			
WELL PURPOSE: <u>HOME</u> (home, irrigation, municipal, industrial)			
WELL COMPLETION DATA:			
(1) diameter (inches) <u>2"</u>			
(2) total depth (feet) <u>105'</u>			
(3) static water level (feet) <u>14'</u> below top of ground.			
(4) casing <u>Plastic</u> , <u>100'</u> (material) (depth)			
(size) If telescope see back.			
(5) screen <u>5'</u> , <u>100'</u> (length) (depth to top)			
<u>2"</u> , <u>Plastic</u> (size) (material)			
(6) pump <u>1</u> , <u>12</u> (HP) (yield gpm)			
<u>Elect</u> (type power)			
(7) electric log <u>no</u> (yes or no)			
(organization running log)			
(8) how well bottom plugged <u>Capped</u>			


DEPT. OF NATURAL RESOURCES
 BUREAU OF LAND & WATER RESOURCES

JAN 18 1980
 RECEIVED

DRILLERS REMARKS:

If well telescopes please sketch and show depths.

GROUND LEVEL

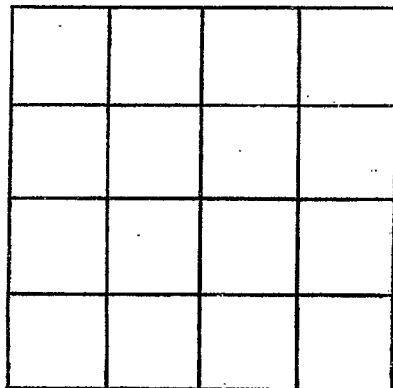

SECTION _____

Please indicate well location X.

ADDITIONAL INFORMATION

If more than one screen,
show locations of each on sketch.