

STONE  
E 2025

MISSISSIPPI  
 BOARD OF WATER COMMISSIONERS  
 416 North State Street  
 Jackson, Mississippi 39201

WATER WELL DRILLERS LOG

5-5-80 1980 Fruffage Well Service STONE  
 date well completed firm name county well located

LANDOWNER: W.R. Seard

description of formations encountered	from	to
<u>Red Clay</u>	<u>0</u>	<u>4</u>
<u>Brown Sand</u>	<u>4</u>	<u>10</u>
<u>Blue Clay</u>	<u>10</u>	<u>31</u>
<u>Five Sand</u>	<u>31</u>	<u>65</u>
<u>Sand</u>	<u>65</u>	<u>75</u>
<u>good Sand</u>	<u>75</u>	<u>80</u>
	<u>80</u>	<u>90</u>

(mailing address)

WELL LOCATION:  
 sec. 5 T. 2 N. R. 10 E  
3 S W  
10 miles SW of Wiggins  
 (distance) (direction) (nearest town)

WELL PURPOSE:  
 home,  irrigation,  municipal,  industrial

WELL COMPLETION DATA: 5-5-80

- (1) diameter (inches) 2"
- (2) total depth (feet) 90'
- (3) static water level (feet) 60'  below,  above top of ground.
- (4) casing PVC, 80'  
 (material) (depth)  
 (size) If telescope see back.
- (5) screen 10', 80'  
 (length) (depth to top)  
2", PVC  
 (size) (material)
- (6) pump 1 logal  
 (HP) (yield gpm)  
E/E  
 (type power)
- (7) electric log (yes or no)  
 (organization running log)

(8) how well bottom plugged 2" PVC  
Back wash Valve

DRILLERS REMARKS:


DEPT. OF NATURAL RESOURCES  
 BUREAU OF LAND & WATER RESOURCES

SEP 29 1980

RECEIVED

If well telescopes please sketch and show depths.

GROUND LEVEL

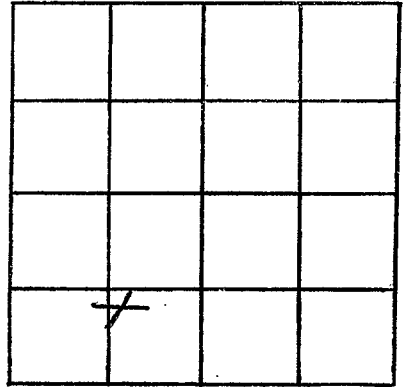

SECTION 14

Please indicate well location X.

ADDITIONAL INFORMATION

If more than one screen,  
show locations of each on sketch.