

Stone
E 2000
3-6-80
3-6

MISSISSIPPI
BOARD OF WATER COMMISSIONERS
416 North State Street
Jackson, Mississippi 39201

WATER WELL DRILLERS LOG

1980 Parnell Anderson Stone
date well completed firm name county well located

LANDOWNER:	description of formations encountered	from	to
Charles McKay	Top Soil	0	2
(mailing address)	Course Sand	2	42
WELL LOCATION: sec. 4 T. 3 N. R. 13 E. S. 5 W.			
1/1 miles W of Wiggins (distance) (direction) (nearest town)			
WELL PURPOSE: HOME (home, irrigation, municipal, industrial)			
WELL COMPLETION DATA:			
(1) diameter (inches) 2"			
(2) total depth (feet) 42'			
(3) static water level (feet) 33' below top of ground.			
(4) casing Plastic 37' (material) (depth)			
(size) If telescope see back.			
(5) screen 5' 37' (length) (depth to top)			
2" Plastic (size) (material)			
(6) pump 1 9 (HP) (yield gpm)			
Elect (type power)			
(7) electric log no (yes or no)			
(organization running log)			
(8) how well bottom plugged Capped			

DEPT. OF NATURAL RESOURCES
BUREAU OF LAND & WATER RESOURCES


APR 29 1980

RECEIVED

DRILLERS REMARKS:

If well telescopes please sketch and show depths.

GROUND LEVEL

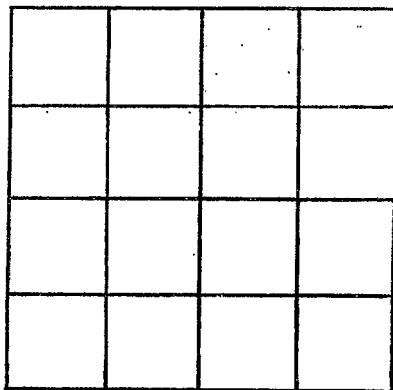

SECTION _____

Please indicate well location X.

ADDITIONAL INFORMATION

If more than one screen,
show locations of each on sketch.