

JANE

MISSISSIPPI
 BOARD OF WATER COMMISSIONERS
 416 North State Street
 Jackson, Mississippi 39201

WATER WELL DRILLERS LOG

6-10-80
6-10
 date well completed

1980 Parrell Anderson
 firm name

Stone
 county well located


LANDOWNER:	description of formations encountered	from	to
<u>P. G. Hickman</u>	<u>Top Soil</u>	<u>0</u>	<u>2</u>
(mailing address)	<u>Steady clay</u>	<u>2</u>	<u>25</u>
WELL LOCATION:	<u>Coarse Sand</u>	<u>25</u>	<u>75</u>
sec. <u>34</u> T. <u>3</u> R. <u>13</u>			
<u>10</u> miles <u>W</u> of <u>Derk</u>			
(distance) (direction) (nearest town)			
WELL PURPOSE: <u>HOME</u>			
(home, irrigation, municipal, industrial)			
WELL COMPLETION DATA:			
(1) diameter (inches) <u>2"</u>			
(2) total depth (feet) <u>75'</u>			
(3) static water level (feet) <u>52</u> below top of ground.			
(4) casing <u>Plastic 70'</u>			
(material) (depth)			
(size) if telescope see back.			
(5) screen <u>5'</u> , <u>70'</u>			
(length) (depth to top)			
<u>2"</u> , <u>Plastic</u>			
(size) (material)			
(6) pump <u>1</u> <u>9</u>			
(HP) (yield gpm)			
<u>Elect</u>			
(type power)			
(7) electric log <u>no</u>			
(yes or no)			
(organization running log)			
(8) how well bottom plugged <u>Capped</u>			
DRILLERS REMARKS:			

DEPT. OF NATURAL RESOURCES
 BUREAU OF LAND & WATER RESOURCES

JUN 18 1980
 RECEIVED

If well telescopes please sketch and show depths.

GROUND LEVEL

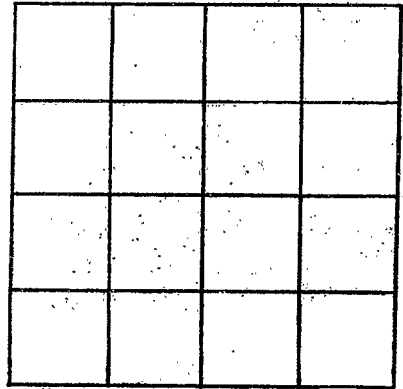

SECTION _____

Please indicate well location X.

ADDITIONAL INFORMATION

If more than one screen,
show locations of each on sketch.