

STONE
E 2028
9-5-80

MISSISSIPPI
BOARD OF WATER COMMISSIONERS
416 North State Street
Jackson, Mississippi 39201

WATER WELL DRILLERS LOG


9-5-1980¹⁹ Parnell Anderson STONE
date well completed firm name county well located
9-5-1980

LANDOWNER: <u>Kiahwell Smith</u>	description of formations encountered	from	to
<u>RT. 2, Box 147</u>	<u>Top soil</u>	<u>0</u>	<u>1</u>
<u>Wiggins Miss</u> (mailing address)	<u>Clay</u>	<u>1</u>	<u>18</u>
WELL LOCATION:			
sec. <u>4 T 3 S</u> R. <u>13 W</u>			
<u>12</u> miles <u>W</u> of <u>Wiggins</u> (distance) (direction) (nearest town)	<u>Sand</u>	<u>18</u>	<u>41</u>
WELL PURPOSE: <u>Home</u> (home, irrigation, municipal, industrial)			
WELL COMPLETION DATA:			
(1) diameter (inches) <u>2</u>			
(2) total depth (feet) <u>41</u>			
(3) static water level (feet) <u>28</u> below above top of ground.			
(4) casing <u>Plastic</u> , <u>36</u> (material) (depth)			
_____ if telescope see back. (size)			
(5) screen <u>5</u> , <u>36</u> (length) (depth to top)			
<u>2</u> , <u>Plastic</u> (size) (material)			
(6) pump <u>1</u> , <u>10</u> (HP) (yield gpm)			
_____ <u>Inductive</u> (type power)			
(7) electric log <u>NO</u> (yes or no)			
_____ (organization running log)			
(8) how well bottom plugged <u>Capped</u>			
DRILLERS REMARKS:			

DEPT. OF NATURAL RESOURCES
BUREAU OF LAND & WATER RESOURCES
JAN 12 1981
RECEIVED

If well telescopes please
sketch and show depths.

GROUND LEVEL

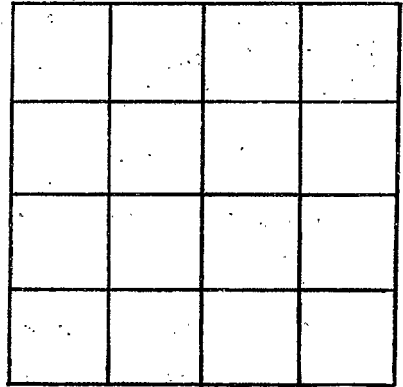

SECTION _____

Please indicate well location X.

ADDITIONAL INFORMATION

If more than one screen,
show locations of each on sketch.