

MISSISSIPPI DEPARTMENT OF NATURAL RESOURCES

Bureau of Land and Water Resources

Southport Mall

P.O. Box 10631

Jackson, Mississippi 39209

WATER WELL DRILLERS LOG

Stone
E2031

4-27
date well completed

Frank Price
firm name

Stone
county well located

LANDOWNER:	description of formations encountered	from	to
Clerk Roberts	Top Soil	0	3
(mailing address)	Clay	3	100
WELL LOCATION:	Course Sand	100	113
sec 29 T 3 R 13			
1 miles S of RUN LAKE			
WELL PURPOSE: H.G.M.F.			
(home, irrigation, municipal, industrial)			
WELL COMPLETION DATA:			
(1) diameter (inches) 2"			
(2) total depth (feet) 113			
(3) static water level (feet) 55' below top of ground.			
(4) casing Plastic 108' (material) (depth)			
_____ If telescope see back. (size)			
(5) screen 5' 108' (length) (depth to top)			
2 Plastic (size) (material)			
(6) pump 1 10 (HP) (yield gpm)			
Elect (type power)			
(7) electric log No (yes or no)			
_____ (organization running log)			
(8) how well bottom plugged Back with valve			
DRILLERS REMARKS:			


DEPT. OF NATURAL RESOURCES
BUREAU OF LAND & WATER RESOURCES

MAY 10 1982

RECEIVED

If well telescopes please
sketch and show depths.

GROUND LEVEL

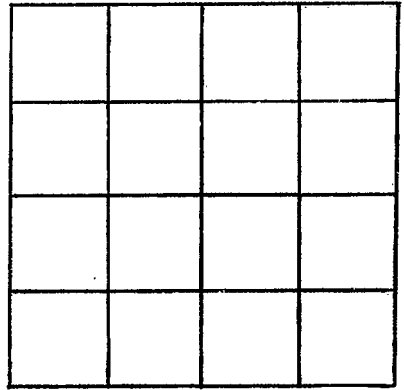

SECTION _____

Please indicate well location X.

ADDITIONAL INFORMATION

If more than one screen,
show locations of each on sketch.