

MISSISSIPPI DEPARTMENT OF NATURAL RESOURCES

Bureau of Land and Water Resources

Southport Mall

P.O. Box 10631

Jackson, Mississippi 39209

WATER WELL DRILLERS LOG

Stone
E 2030

9-9 1983
date well completed

Frank Price
firm name

Stone
county well located

LANDOWNER:
Dale Main

(mailing address)

WELL LOCATION:
sec 20 T 3 N R 13 E
S 1/4 miles N of Brown Lake
(distance) (direction) (nearest town)

description of formations encountered	from	to
<u>Top Soil</u>	<u>0</u>	<u>2</u>
<u>Sandy clay</u>	<u>2</u>	<u>28</u>
<u>Coarse Sand</u>	<u>28</u>	<u>45</u>
<u>Clay</u>	<u>45</u>	<u>90</u>
<u>Fin Sand</u>	<u>90</u>	<u>116</u>

WELL PURPOSE: HOME
(home, irrigation, municipal, industrial)

WELL COMPLETION DATA:

(1) diameter (inches) 2"

(2) total depth (feet) 116'

(3) static water level (feet) 96' below above top of ground.

(4) casing Plastic, 106'
(material) (depth)

_____ if telescope see back.
(size)

(5) screen 10 / 106
(length) (depth to top)

2" / Plastic
(size) (material)

(6) pump 1 1/2 / 4
(HP) (yield gpm)

Elect
(type power)

(7) electric log No
(yes or no)

_____ (organization running log)

(8) how well bottom plugged B.C.M.V.

DRILLERS REMARKS:


DEPT. OF NATURAL RESOURCES
BUREAU OF LAND & WATER RESOURCES

OCT 3 1983

RECEIVED

If well telescopes please sketch and show depths.

GROUND LEVEL

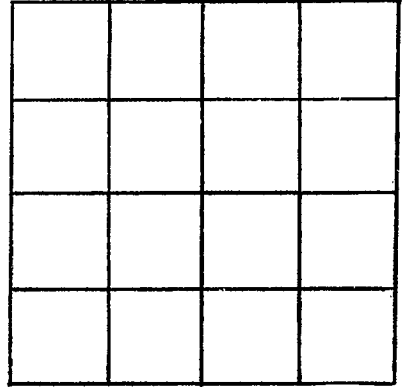

SECTION _____

Please indicate well location X.

ADDITIONAL INFORMATION

If more than one screen,
show locations of each on sketch.