

MISSISSIPPI DEPARTMENT OF NATURAL RESOURCES

Bureau of Land and Water Resources

Southport Mall

P.O. Box 10631

Jackson, Mississippi 39209

WATER WELL DRILLERS LOG

Stone
E 2037

11-8 1983 Frank Price Stone
 date well completed firm name county well located

LANDOWNER:	description of formations encountered	from	to
<u>Dan Batson</u>	<u>Top Soil</u>	<u>0</u>	<u>2</u>
(mailing address)	<u>Sandy clay</u>	<u>2</u>	<u>22</u>
WELL LOCATION:	<u>medium sand</u>	<u>22</u>	<u>80</u>
sec. <u>11</u> T. <u>3</u> S. R. <u>13</u> W.	<u>Coarse sand</u>	<u>80</u>	<u>106</u>
<u>7</u> miles <u>W</u> of <u>Perk</u>			
(distance) (direction) (nearest town)			
WELL PURPOSE: <u>Domestic</u>			
(home, irrigation, municipal, industrial)			
WELL COMPLETION DATA:			
(1) diameter (inches) <u>4"</u>			
(2) total depth (feet) <u>106'</u>			
(3) static water level (feet) <u>50'</u> below top of ground.			
(4) casing <u>Plastic</u> , <u>101'</u> (material) (depth)			
(size) if telescope see back.			
(5) screen <u>10'</u> , <u>96'</u> (length) (depth to top)			
<u>4"</u> , <u>Plastic</u> (size) (material)			
(6) pump <u>1</u> (HP) <u>30</u> (yield gpm)			
<u>Elect</u> (type power)			
(7) electric log <u>no</u> (yes or no)			
(organization running log)			
(8) how well bottom plugged <u>B.W.V.</u>			
DRILLERS REMARKS:			


DEPT. OF NATURAL RESOURCES
 BUREAU OF LAND & WATER RESOURCES

DEC - 9 1983

RECEIVED

If well telescopes please sketch and show depths.

GROUND LEVEL

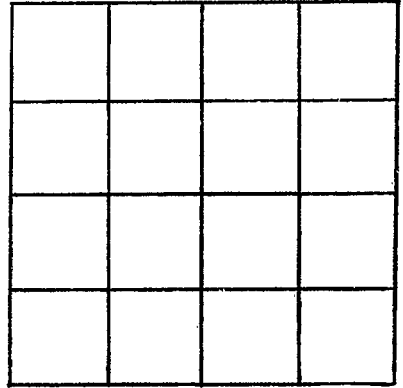

SECTION _____

Please indicate well location X.

ADDITIONAL INFORMATION

If more than one screen,
show locations of each on sketch.