

MISSISSIPPI DEPARTMENT OF NATURAL RESOURCES

Bureau of Land and Water Resources

Southport Mall

P.O. Box 10631

Jackson, Mississippi 39209

WATER WELL DRILLERS LOG

STONE
E 2042

5-7
date well completed

1984

Frank Price
firm name

Stone
county well located

LANDOWNER:

Gary Roger

(mailing address)

WELL LOCATION:

sec 29 T 3 S R 13 E
1 miles N of Silver Run Lake
(distance) (direction) (nearest town)

WELL PURPOSE: HOME
(home, irrigation, municipal, industrial)

WELL COMPLETION DATA:

- (1) diameter (inches) 2"
- (2) total depth (feet) 112'
- (3) static water level (feet) 56' below top of ground.
- (4) casing PVC, 107' (material) (depth)
- (5) screen 5' length, 107' depth to top, 2" size, PVC material
- (6) pump 1 (HP), 9 (yield gpm), Elect (type power)
- (7) electric log no (yes or no)

(organization running log)

(8) how well bottom plugged B.W.V.

DRILLERS REMARKS:

description of formations encountered

from

to

Top Soil 0 3
Clay 3 90
Medians Sand 90 112'


DEPT. OF NATURAL RESOURCES
BUREAU OF LAND & WATER RESOURCES

JUL 11 1984

RECEIVED

If well telescopes please
sketch and show depths.

GROUND LEVEL

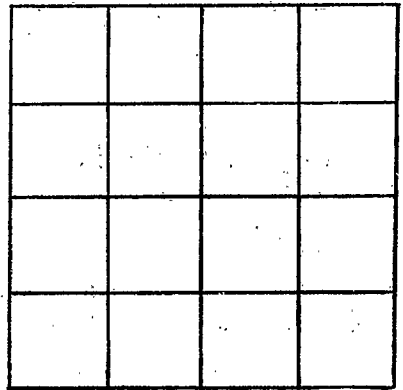

SECTION _____

Please indicate well location X.

ADDITIONAL INFORMATION

If more than one screen,
show locations of each on sketch.