

STONE
F
8-68

MISSISSIPPI
BOARD OF WATER COMMISSIONERS
416 North State Street
Jackson, Mississippi 39201

WATER WELL DRILLERS LOG

8-16 19 68 Hattiesburg Butane Stone
date well completed firm name county well located

LANDOWNER:

Freddie Owens

description of formations encountered

from to

Perkinston, Miss.
(mailing address)

yellow clay 0-21
yellow sand 21-27
white sand 27-34
white clay 34-40
white sand 40-87
whitesand + gravel 87-106
white sand 106-145
white sand + gravel 145-183

WELL LOCATION:


sec. 17 T. 3 N R. 12 E
S W
4 mi miles West of Perkinston
(distance) (direction) (nearest town)

WELL PURPOSE:

(home, irrigation, municipal, industrial) OR gas

WELL COMPLETION DATA:


- (1) diameter (inches) 2
- (2) total depth (feet) 183
- (3) static water level (feet) 126 below top of ground.
- (4) casing galv pipe 183 (material) (depth)
2 (size) if telescope see back.
- (5) screen 10' 183 (length) (depth to top)
2" BRONZE (size) (material)
- (6) pump electric 400 (HP) (yield gpm)
1 HP (type power)
- (7) electric log NO (yes or no)
NO (organization running log)
- (8) how well bottom plugged BACK WASH VALVE.

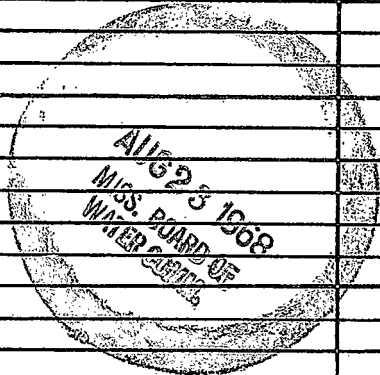

DRILLERS REMARKS:

If well telescopes please
sketch and show depths.

GROUND LEVEL

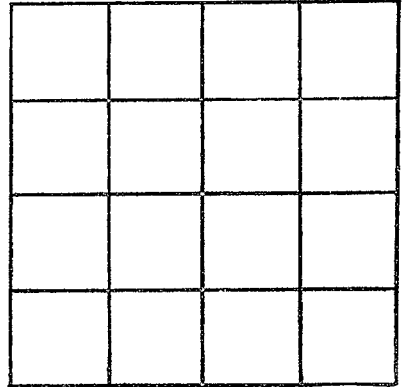

SECTION _____

Please indicate well location X.

ADDITIONAL INFORMATION

If more than one screen,
show locations of each on sketch.