


Stone  
F  
8-68

MISSISSIPPI  
BOARD OF WATER COMMISSIONERS  
416 North State Street  
Jackson, Mississippi 39201

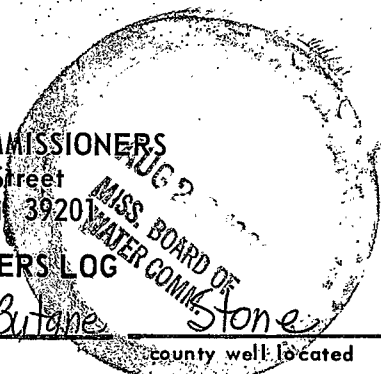

WATER WELL DRILLERS LOG

8-23 1968 Hattiesburg Butane Stone  
date well completed firm name county well located

LANDOWNER:

Buster Whittle

Perkinston, Miss.  
(mailing address)

description of formations encountered

from to

yellow clay 0-21  
white sand 21-100  
white sand & gravel 100-137

WELL LOCATION:

sec. 17 T. 3 N R. 12 E  
S W  
4 miles West of Perkinston  
(distance) (direction) (nearest town)

WELL PURPOSE:

(home, irrigation, municipal, industrial)


WELL COMPLETION DATA:

- (1) diameter (inches) 2"
- (2) total depth (feet) 137
- (3) static water level (feet) 98 below top of ground.
- (4) casing galv pipe 137, (material) (depth)  
2 (size) if telescope see back.
- (5) screen 10' (length), (depth to top)  
2" (size), stainless s. (material)
- (6) pump 1 (HP), 400 (yield gpm)  
electric (type power)
- (7) electric log NO (yes or no)  
NO (organization running log)
- (8) how well bottom plugged  
BACK WASH VALVE

DRILLERS REMARKS:

If well telescopes please sketch and show depths.

GROUND LEVEL

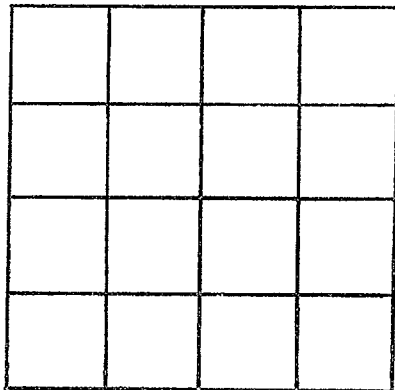

SECTION \_\_\_\_\_

Please indicate well location X.

ADDITIONAL INFORMATION

If more than one screen, show locations of each on sketch.