

STONE MISSISSIPPI BOARD OF WATER COMMISSIONERS

F5

4-30-65

WATER WELL DRILLERS LOG

CODED

Date: April 30, 1965, Driller: JAY COTT
 1632 (Name)

County STONE

(1) Owner of Land: LEROY M. QUEEN
 (Name)

PERKINSON, MISS.
 (Address)

(2) Location: 1/4, 1/4, Sec. 13 T3 R12
1 miles Southwest of PERKINSON
 (distance) (direction) (Nearest Town)

(3) Topography: (Hilly) (Flat) (Level)

(4) Purpose of Well: (Domestic, Irrigation, Municipal, Industrial, Other)

Description & Color of Materials
 Sand, Clay, Red Clay, Shell, etc.

Thick-
 ness
 Feet

Depth
 Feet

0 - 8 - Y-C
8 - 68 - WS

24 FEET TO WATER

Information upon completion of well:


- (1) Diameter 2 inches.
- (2) Total Depth 68 feet.
- (3) Water Level 24 feet below top of ground.
- (4) Cased to 2, Size 2
- (5) Screen: Size 2, Length 10
- (6) Were any formations sealed against pollution?
yes, no.

CODED

If YES depth of formation _____

Why _____

Drillers Remarks: _____

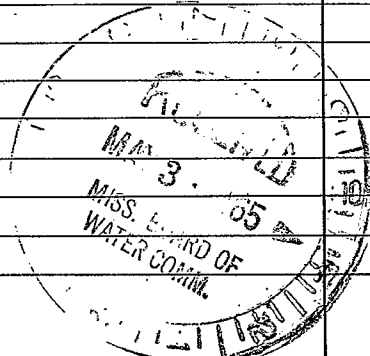

(Use Back Side)

Well No.

