

Stone  
F6  
3-67

MISSISSIPPI  
BOARD OF WATER COMMISSIONERS  
416 North State Street  
Jackson, Mississippi 39201

WATER WELL DRILLERS LOG

3-22-1967 HATTIESBURG BUTANE STONE  
date well completed firm name county well located


LANDOWNER: Katherine Kennedy  
Perkinston, Miss.  
(mailing address)

description of formations encountered	from	to
Red SAND	0	65
White SAND	65	84
Gravel	84	87
White SAND	87	200

WELL LOCATION:  
sec 13 T. 3 S R. 12 W  
5 miles South of Wiggins  
(distance) (direction) (nearest town)

WELL PURPOSE: Home  
(home, irrigation, municipal, industrial)

- WELL COMPLETION DATA:
- (1) diameter (inches) 2"
  - (2) total depth (feet) 200'
  - (3) static water level (feet) 100' below top of ground.
  - (4) casing GAL. pipe, 187' (material) (depth)  
2" (size) if telescope see back.
  - (5) screen 10' 190' (length) (depth to top)  
2" (size) BRONZE (material)
  - (6) pump 1 MSE #350 (HP) (yield gpm)  
Electric (type power)
  - (7) electric log NO (yes or no)  
NO (organization running log)
  - (8) how well bottom plugged BACK WASH VALVE

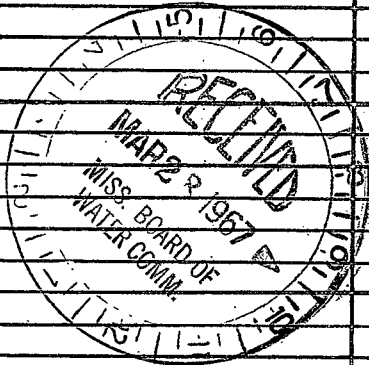

DRILLERS REMARKS:

If well telescopes please sketch and show depths.

GROUND LEVEL

X			

SECTION 13

Please indicate well location X.

ADDITIONAL INFORMATION

If more than one screen;  
show locations of each on sketch.