

MISSISSIPPI  
BOARD OF WATER COMMISSIONERS  
416 North State Street  
Jackson, Mississippi 39201

WATER WELL DRILLERS LOG

Stone  
F7  
3-67

MARCH 20, 1967 HATTIESBURG Butane Stone  
date well completed firm name county well located

LANDOWNER: TERRY MURRAY  
Perkinston, Miss.  
  
(mailing address)


WELL LOCATION:  
sec 13 T. 3 S. R. 12 W.  
5 miles South of Wiggins  
(distance) (direction) (nearest town)

WELL PURPOSE: Home  
(home, irrigation, municipal, industrial)

WELL COMPLETION DATA:

- (1) diameter (inches) 2"
- (2) total depth (feet) 100'
- (3) static water level (feet) 41' below top of ground
- (4) casing 2" pipe 92'  
(material) (depth)
- 2" if telescope see back.  
(size)
- (5) screen 5' 95'  
(length) (depth to top)
- 2" Plastic  
(size) (material)
- (6) pump 1/2 325  
(HP) (yield gpm)
- Electric  
(type power)
- (7) electric log NO  
(yes or no)
- NO  
(organization running log)
- (8) how well bottom plugged  
BACK WASH VALVE


description of formations encountered	from	to
Red clay	0	5
White clay	5	19
Red clay	19	23
White clay	23	26
Red clay	26	35
Blue & Red clay	35	40
White sand	40	100

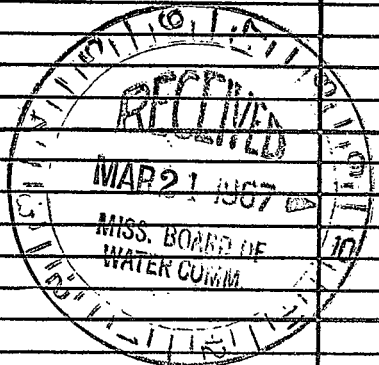

DRILLERS REMARKS:

If well telescopes please sketch and show depths.

GROUND LEVEL

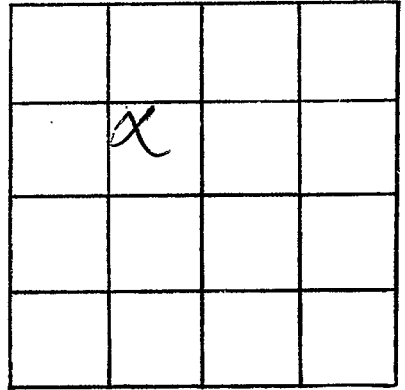

SECTION 23

Please indicate well location X.

ADDITIONAL INFORMATION

If more than one screen, show locations of each on sketch.