

MISSISSIPPI
BOARD OF WATER COMMISSIONERS
416 North State Street
Jackson, Mississippi 39201

WATER WELL DRILLERS LOG

MARCH 20, 1967 Hattiesburg Butane Stone
 date well completed firm name county well located

LANDOWNER: Josephine Nicholson
 Perkinston, Miss
 (mailing address)

description of formations encountered

from to


Red clay	0	5
White clay	5	30
Blue clay	30	38
Yellow clay	38	43
White clay	43	48
White sand	48	110

WELL LOCATION:
 sec 13 T 3 N R 12 W
 S W
 5 miles South of Wiggins
 (distance) (direction) (nearest town)

WELL PURPOSE: Home
 (home, irrigation, municipal, industrial)

WELL COMPLETION DATA:


- (1) diameter (inches) 2"
- (2) total depth (feet) 110'
- (3) static water level (feet) 44' below top of ground.
- (4) casing Plastic 102'
 (material) (depth)
 2" (size) if telescope see back.
- (5) screen 5' 102'
 (length) (depth to top)
 # 8-2" PLASTIC
 (size) (material)
- (6) pump 1/2 325
 (HP) (yield gpm)
 electric 904
 (type power)
- (7) electric log NO
 (yes or no)
 NO
 (organization running log)
- (8) how well bottom plugged
 BACK WASH VALVE

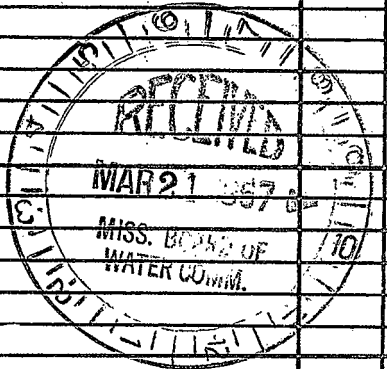

DRILLERS REMARKS:

If well telescopes please sketch and show depths.

GROUND LEVEL

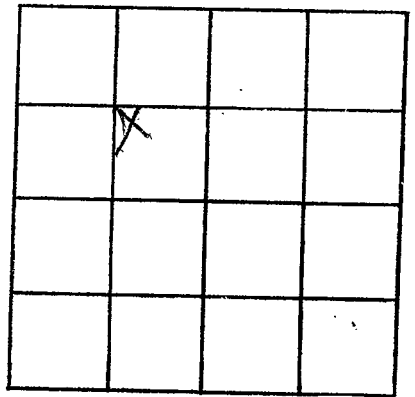

SECTION 13

Please indicate well location X.

ADDITIONAL INFORMATION

If more than one screen,
show locations of each on sketch.