

Stone
79
8-67

MISSISSIPPI
BOARD OF WATER COMMISSIONERS
416 North State Street
Jackson, Mississippi 39201

WATER WELL DRILLERS LOG

8-1 1967 Hattiesburg Butane Stone
date well completed firm name county well located

LANDOWNER: Lottie Cannon
Perkinston, Miss.

(mailing address)


WELL LOCATION:
sec. 13 T. 3 S. R. 12 W. ✓
5 miles south of Williams
(distance) (direction) (nearest town)

WELL PURPOSE: Home
(home, irrigation, municipal, industrial)

WELL COMPLETION DATA:

- (1) diameter (inches) 2"
- (2) total depth (feet) 83
- (3) static water level (feet) 42' below top of ground.
- (4) casing Plastic, 73' (material), (depth),
2" (size) if telescope see back.
- (5) screen 10' 73' (length), (depth to top)
2" Plastic (size), (material)
- (6) pump 1/2 325 (HP), (yield gpm)
Electric (type power)
- (7) electric log NO (yes or no)
NO (organization running log)
- (8) how well bottom plugged BACK WASH VALVE

description of formations encountered	from	to
Red clay	0	5
white clay	6	12
yellow clay	13	15
white clay	16	21
red clay	22	23
white clay	24	28
blue clay	29	33
white clay	34	50
white sand	51	83

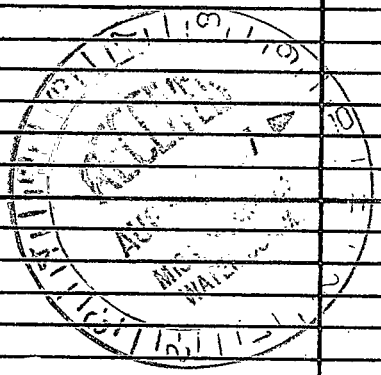

DRILLERS REMARKS:

If well telescopes please sketch and show depths.

GROUND LEVEL

			X 13

SECTION 13

Please indicate well location X.

ADDITIONAL INFORMATION

*Near Katherine Kennedy well
out from Perkinston 7 west*

If more than one screen,
show locations of each on sketch.